

LOWNDES

WATER WELL DRILLERS LOG

CODED

AM 22
9-26-61

Date: Sept 26, 1961, Driller: W. B. Clardy County Lowndes
(Name)

13794, 95

(1) Owner of Land: Bob Reeves
changed

New Hope
(Name)
(Address)

(2) Location: SW NE NW
1/4, 1/4, Sec. 4 T19R 17N

 miles of
(distance) (direction) (Nearest Town)

(3) Topography: (Hilly) (Flat) (Level)

(4) Purpose of Well: (Domestic Irrigation) (Municipal, Industrial, Other)

| Description & Color of Materials Sand, Clay, Red Clay, Shell, etc. | Thick- ness Feet | Depth Feet |
|---|------------------------|---------------------|
| <u>Sandy formation to</u> | | <u>19'</u> |
| <u>Blue clay at</u> | | <u>19' - 178'</u> |
| <u>Sand -</u> | | <u>178' to 200'</u> |
| <u>Red Clay</u> | | <u>200' - 265'</u> |
| <u>Sand</u> | | <u>265 - 285'</u> |

Information upon completion of well:

(1) Diameter 4 inches.

(2) Total Depth 285 feet.

(3) Water Level 85' feet below top of ground.

(4) Cased to 53, Size _____, Length _____.

(5) Screen: Size _____, Length _____.

(6) Were any formations sealed against pollution?


_____ yes, _____ no.

If YES depth of formation _____

Why _____

Drillers Remarks: _____

CODED

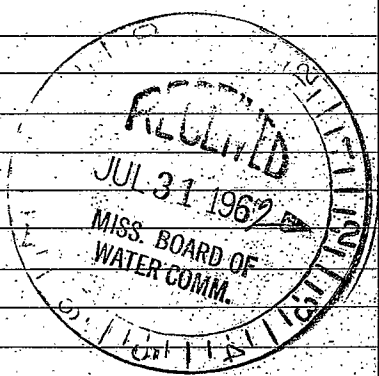

(Use Back Side)

Well No.

100