

LOWNDES

M23

WATER WELL DRILLERS LOG

CODED

8-17-60

Date: Aug 17, 1960, Driller: W. B. Clardy County Lowndes

NEW PETER D'BRIAN

(Name)

(1) Owner of Land: Mrs J. Helbert
(Name)

(Address)

(2) Location: NE 1/4, NW 1/4, Sec. 3 T19R17

8 miles S.E. of Columbus
(distance) (direction) (Nearest Town)

(3) Topography: (Hilly) (Flat) (Level)

(4) Purpose of Well: Domestic
(Domestic Irrigation, Municipal, Industrial, Other)

Description & Color of Materials Sand, Clay, Red Clay, Shell, etc.	Thick- ness Feet	Depth Feet
<u>Blue Clay</u>	<u>18'</u>	<u>to 140'</u>
<u>Sand</u>	<u>100'</u>	<u>to 115'</u>
<u>Clay</u>	<u>115'</u>	<u>to 135'</u>
<u>Sand</u>	<u>135'</u>	<u>to 140'</u>
<u>Clay</u>	<u>140'</u>	<u>to 149'</u>
<u>Sand</u>	<u>149'</u>	<u>to 155'</u>

Information upon completion of well:


- (1) Diameter 4 inches.
- (2) Total Depth 160 feet.
- (3) Water Level 85 feet below top of ground.
- (4) Cased to 43, Size 4"
- (5) Screen: Size _____, Length _____
- (6) Were any formations sealed against pollution?
_____ yes, _____ no.

If YES depth of formation _____

Why _____

Drillers Remarks: _____

CODED

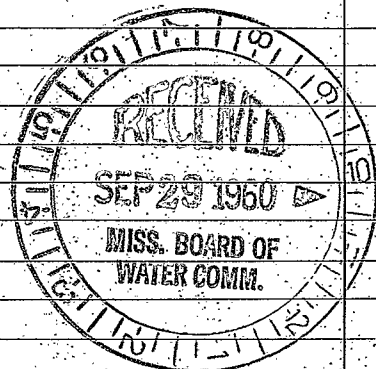

(Use Back Side)

Well No.

