

**CODED**

MISSISSIPPI  
BOARD OF WATER COMMISSIONERS  
416 North State Street  
Jackson, Mississippi 39201

Lowndes  
M 26  
5-26-70

WATER WELL DRILLERS LOG

5-26-1970 MS. K. Gray Lowndes  
date well completed firm name county well located

LANDOWNER: Bob. Fletcher  
Columbus miss

description of formations encountered	from	to
Grey Clay	0	25
<del>Blue clay</del> Blue clay	25	118
Blue Shale and shallow sand streaks	118	264
Firm sand	264	300

(mailing address)

WELL LOCATION:  
sec. 4 T. 19 N R. 10 E  
19 S  
6 miles S.E. of Columbus  
(distance) (direction) (nearest town)

WELL PURPOSE: Farm  
(home, irrigation, municipal, industrial)

WELL COMPLETION DATA:

- (1) diameter (inches) 4 inch
- (2) total depth (feet) 300'
- (3) static water level (feet) 72 below top of ground.
- (4) casing Steel, 80' (material) (depth)
- (5) screen (length) (depth to top) (size) (material)
- (6) pump (HP) (yield gpm) (type power)
- (7) electric log NO (yes or no)

**CODED**

(organization running log)

(8) how well bottom plugged


JUN 18 1970

MISS. BD. OF  
WATER COMM.

DRIFTERS AND GEWAY  
Water Well Drilling  
FERNBANK, AL., Phone  
MILLPORT, AL. 662-427.

If well telescopes please sketch and show depths.

GROUND LEVEL

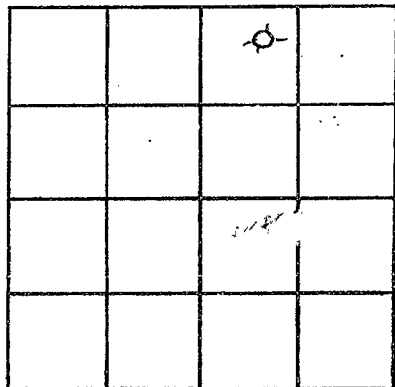

SECTION 4

Please indicate well location X.

ADDITIONAL INFORMATION

If more than one screen,  
show locations of each on sketch.