

LOWNDES
M 27
5-4-72

MISSISSIPPI
 BOARD OF WATER COMMISSIONERS
 416 North State Street
 Jackson, Mississippi 39201

CODED

WATER WELL DRILLERS LOG

5-4 1972 W. J. REEVES & SON LOWNDES
 date well completed firm name county well located

LANDOWNER: MARVIN CASH

description of formations encountered

from

to

HIGHWAY 82 E.

COLUMBUS
 (mailing address)

WELL LOCATION:

sec. 8 T. 19 N. R. 17 W.
7 miles SE of COLUMBUS
 (distance) (direction) (nearest town)

<u>RED CLAY</u>	<u>0</u>	<u>28</u>
<u>RED SAND</u>	<u>28</u>	<u>32</u>
<u>BLUE CLAY</u>	<u>32</u>	<u>77</u>
<u>BLUE SD. + CLAY STRS</u>	<u>77</u>	<u>124</u>
<u>BLUE CLAY</u>	<u>124</u>	<u>200</u>
<u>BLUE SAND</u>	<u>200</u>	<u>212</u>
<u>BLUE CLAY</u>	<u>212</u>	<u>221</u>
<u>BLUE SAND</u>	<u>221</u>	<u>239</u>
<u>BLUE CLAY + SD. STRS</u>	<u>239</u>	<u>280</u>

WELL PURPOSE: FAMILY
 (home, irrigation, municipal, industrial)

WELL COMPLETION DATA:

(1) diameter (inches) 4

(2) total depth (feet) 280

(3) static water level (feet) 85 below above top of ground.

(4) casing STEEL, 39 1/2
 (material) (depth)

4 if telescope-see back.
 (size)

(5) screen NONE
 (length) (depth to top)

(size) (material)

(6) pump F, 20
 (HP) (yield gpm)

ELECT
 (type power)

(7) electric log NO
 (yes or no)

(organization running log)

(8) how well bottom plugged OPEN

CODED


JUNE 01 1972
 JUN 2

MISS. BD. OF
 WATER COMMISSIONERS

DRILLERS REMARKS:

If well telescopes please sketch and show depths.

GROUND LEVEL

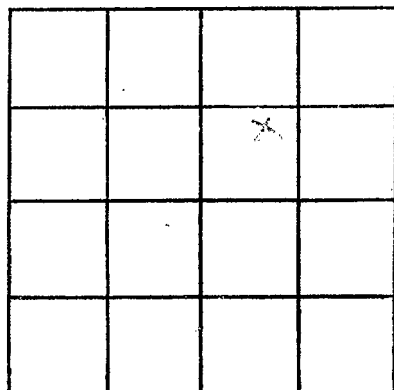

SECTION 2

Please indicate well location X.

ADDITIONAL INFORMATION

If more than one screen, show locations of each on sketch.