

LOWNDES
M28
7-6-72

MISSISSIPPI
 BOARD OF WATER COMMISSIONERS
 416 North State Street
 Jackson, Mississippi 39201

CODED

WATER WELL DRILLERS LOG

7/6/72 19 Clardy Well Pump Service Lowndes
 date well completed firm name county well located

LANDOWNER: Charles O' Bryant
Route 4, New Hope
Columbus, Miss 39701
 (mailing address)

description of formations encountered	from	to
red clay	0	10
sand + gravel	10	18
blue clay	18	52
sandy blue clay	52	63
blue clay	63	65
sandy blue clay	65	70
rocks	70	72
blue clay	72	80
rock	80	81
blue clay	81	85
rocks	85	86
blue clay	86	125
sandy blue clay	125	132
blue clay	132	145
sandy blue clay	145	150
rocks	150	151
blue clay	151	165
fine sand + clay	165	170
blue clay	170	172
fine sand	172	180
blue clay	180	190
fine sand	190	193
blue clay	193	195
rock	195	196
coars	196	210

WELL LOCATION:
 sec. 5 T. 19 N R. 17 E
5 miles SE of Columbus
 (distance) (direction) (nearest town)

WELL PURPOSE:
 (home, irrigation, municipal, industrial)

WELL COMPLETION DATA:

- (1) diameter (inches) 4"
- (2) total depth (feet) 210'
- (3) static water level (feet) 90' ^{below} above top of ground.
- (4) casing 4" Steel, 96'
 (material) (depth)
- _____ if telescope see back.
 (size)
- (5) screen _____
 (length) (depth to top)
- _____ (size) _____ (material)
- (6) pump 1/2 Sub. 11
 (HP) (yield gpm)
- _____ (type power)
- (7) electric log _____
 (yes or no)
- _____ (organization running log)
- (8) how well bottom plugged OPEN

CODED


JUL 31 1972

DRILLERS REMARKS:

MISC. BD. OF
 WATER COM.

If well telescopes please sketch and show depths.

GROUND LEVEL

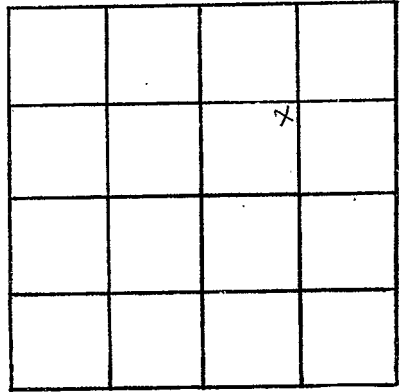

SECTION _____

Please indicate well location X.

ADDITIONAL INFORMATION

If more than one screen,
show locations of each on sketch.