

LOWNDES  
M30  
7-25-72

MISSISSIPPI  
BOARD OF WATER COMMISSIONERS  
416 North State Street  
Jackson, Mississippi 39201

**CODED**

WATER WELL DRILLERS LOG

7/25 1972 P.R. Drilling Co. (Landowner)  
date well completed firm name county well located

LANDOWNER: A.I. Funder  
1301 Military Rd.  
Columbus Miss 39701  
(mailing address)

description of formations encountered	from	to
<u>Top of ground</u>		
<u>Clay</u>		<u>15</u>
<u>Blue rock</u>	<u>15</u>	<u>70</u>
<u>Sand</u>	<u>70</u>	<u>140</u>

WELL LOCATION:  
sec. 17 T. 19 N. R. 17 E  
10 miles South of Columbus  
(distance) (direction) (nearest town)

WELL PURPOSE: Home  
(home, irrigation, municipal, industrial)

WELL COMPLETION DATA:

(1) diameter (inches) 4 inch

(2) total depth (feet) 140

(3) static water level (feet) 20 below above top of ground.

(4) casing PVC Plastic 20 feet  
(material) (depth)

4" If telescope see back.  
(size)

(5) screen None  
(length) (depth to top)

(size) (material)

(6) pump 1-H 6  
(HP) (yield gpm)

Elec.  
(type power)

(7) electric log                       
(yes or no)

                      
(organization running log)

(8) how well bottom plugged None

**CODED**

SEP 1 1972  
1972


MISC. USE  
WATER

DRILLERS REMARKS:

If well telescopes please sketch and show depths.

GROUND LEVEL

20 ft. Casing  
120 feet  
no casing

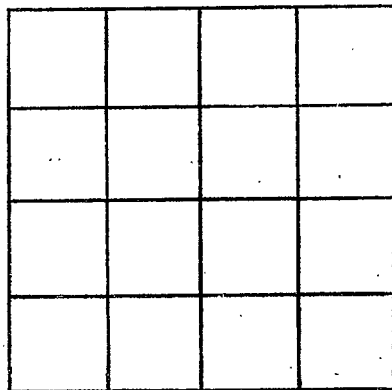

SECTION \_\_\_\_\_

Please indicate well location X.

ADDITIONAL INFORMATION

If more than one screen,  
show locations of each on sketch.