

MISSISSIPPI
BOARD OF WATER COMMISSIONERS
416 North State Street
Jackson, Mississippi 39201

CODED

WATER WELL DRILLERS LOG

LOWNDES
M 33
11-1-72

11-1 1972 W.S. REEVES SON LOWNDES
date well completed firm name county well located

LANDOWNER: W.D. THURSTON

RT. 3

COLUMBUS

(mailing address)

WELL LOCATION:

sec. 28 T. 19 N R. 17 E

6 miles W of COLUMBUS
(distance) (direction) (nearest town)

WELL PURPOSE: HOME
(home, irrigation, municipal, industrial)

WELL COMPLETION DATA:

- (1) diameter (inches) 4
- (2) total depth (feet) 420
- (3) static water level (feet) 95 below above top of ground.
- (4) casing ST 26
(material) (depth)
4 if telescope see back.
(size)
- (5) screen NONE
(length) (depth to top)
(size) (material)
- (6) pump 1 6
(HP) (yield gpm)
ELECT
(type power)
- (7) electric log NO
(yes or no)
(organization running log)
- (8) how well bottom plugged OPEN

description of formations encountered

from

to

BLUE CLAY	0	285
" SAND	285	305
" CLAY	305	343
" SAND	343	355
" CLAY	355	376
" SAND	376	420


CODED

FEB 15 1973

DRILLERS REMARKS:

If well telescopes please sketch and show depths.

GROUND LEVEL

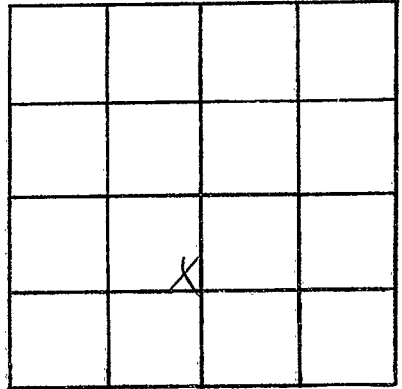

SECTION 28

Please indicate well location X.

ADDITIONAL INFORMATION

If more than one screen, show locations of each on sketch.