

LOWNDES
M34
9-7-73

MISSISSIPPI
BOARD OF WATER COMMISSIONERS
416 North State Street
Jackson, Mississippi 39201

OCT 19 1973

CODED

WATER WELL DRILLERS LOG

MISS. WATER

Sept 7 1973 C Hardy Well & Pump Lowndes
date well completed firm name county well located

LANDOWNER: Ralph Williamson

description of formations encountered

from to

Airline Mfg. Co.

red clay

0 10

Columbus, Miss.

red sand

10 20

(mailing address)

sand + gravel

20 30

WELL LOCATION:

sec 20 T 19 S R 17 E

8 miles S of Colo.

(distance) (direction) (nearest town)

hard sandy clay

30 50

streaks of sand + clay

50 95

blue clay

95 140

sandy blue clay

140 150

blue clay

150 180

sandy blue clay

180 195

blue clay

195 275

fine sand

275 290

sand

290 315

WELL PURPOSE: home
(home, irrigation, municipal, industrial)

WELL COMPLETION DATA:

(1) diameter (inches) 4"

(2) total depth (feet) 315

(3) static water level (feet) 65 below top of ground.

(4) casing 4" steel, 101
(material) (depth)

if telescope see back.
(size)

(5) screen 0
(length) (depth to top)

(size) (material)

(6) pump 0
(HP) (yield gpm)

(type power)

(7) electric log
(yes or no)

(organization running log)


(8) how well bottom plugged

CODED

DRILLERS REMARKS: D wner installed own pump

If well telescopes please sketch and show depths.

GROUND LEVEL

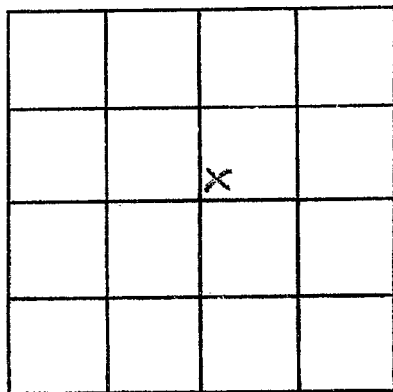

SECTION 20

Please indicate well location X.

ADDITIONAL INFORMATION

If more than one screen,
show locations of each on sketch.