

LOWNDES
M36
7-17-74

MISSISSIPPI
 BOARD OF WATER COMMISSIONERS
 416 North State Street
 Jackson, Mississippi 39201

WATER WELL DRILLERS LOG

7-17 1974 **W. J. REEVES & SON** **LOWNDES**
 date well completed firm name county well located


LANDOWNER: <u>EL. RYANS</u> <u>RT. 4</u>	description of formations encountered	from	to
<u>COLUMBUS</u> (mailing address)	<u>CLAY</u>	<u>0</u>	<u>16</u>
	<u>SAND & GRAVEL</u>	<u>16</u>	<u>33</u>
	<u>BLUE CLAY</u>	<u>33</u>	<u>118</u>
WELL LOCATION: sec. <u>30</u> T. <u>19</u> N. <u>8</u> S. R. <u>17W</u> E. <u>1</u> W.	<u>" SAND</u>	<u>118</u>	<u>127</u>
<u>8</u> miles <u>S</u> of <u>COLUMBUS</u>	<u>" CLAY</u>	<u>127</u>	<u>136</u>
(distance) (direction) (nearest town)	<u>" SAND</u>	<u>136</u>	<u>160</u>
WELL PURPOSE: (home, irrigation, municipal, industrial)			
WELL COMPLETION DATA:			
(1) diameter (inches) <u>4</u>			
(2) total depth (feet) <u>160</u>			
(3) static water level (feet) <u>1</u> below above top of ground.			
(4) casing <u>STEEL</u> , <u>41</u> (material), (depth)			
<u>4</u> If telescope see back. (size)			
(5) screen <u>NOVE</u> (length) (depth to top)			
(6) pump <u>1/2</u> (HP) <u>10</u> (material) (yield gpm)			
<u>ELECT</u> (type power)			
(7) electric log <u>NO</u> (yes or no)			
(organization running log)			
(8) how well bottom plugged <u>OPEN</u>			
DRILLERS REMARKS:			

RECORDED
 INDEXED
 MAR 1 1975

MISS. BD. OF WATER

If well telescopes please sketch and show depths.

GROUND LEVEL

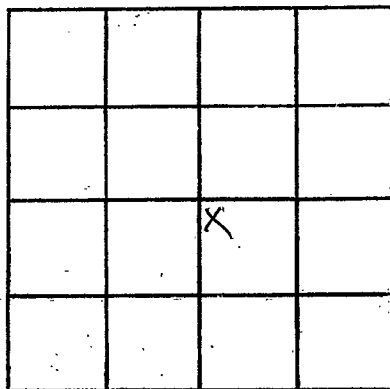

SECTION 30

Please indicate well location X.

ADDITIONAL INFORMATION

If more than one screen,
show locations of each on sketch.