

11-63 *2000*

WATER WELL DRILLERS LOG

Date: Nov., 1963, Driller: W B Clardy County Lewis

11280

(Name)

(1) Owner of Land:	Description & Color of Materials	Thickness Feet	Depth Feet
<u>Ray Jarvin</u> <u>Construction Co.</u> (Native) (Address)	<u>Sandy formation to</u>		<u>35'</u>
	<u>Clay</u>		<u>135-320</u>
(2) Location: $\frac{1}{4}$, $\frac{1}{4}$; Sec. <u>18</u> T <u>19</u> R <u>17</u>	<u>sand, blue rock</u>		<u>320-365</u>
<u> </u> miles <u> </u> , of <u> </u> (distance) (direction) (Nearest Town)			
(3) Topography: <u>Hilly</u> (Hilly) (Flat) (Level)			
(4) Purpose of Well: <u>Domestic</u> (Domestic Irrigation Municipal, Industrial, Other)			


Information upon completion of well:

- (1) Diameter 4 inches.
- (2) Total Depth 365' feet.
- (3) Water Level _____ feet below top of ground.
- (4) Cased to 135', Size 4"
- (5) Screen: Size _____, Length _____.
- (6) Were any formations sealed against pollution?
_____ yes, _____ no.

If YES depth of formation _____

Why _____

Drillers Remarks: _____

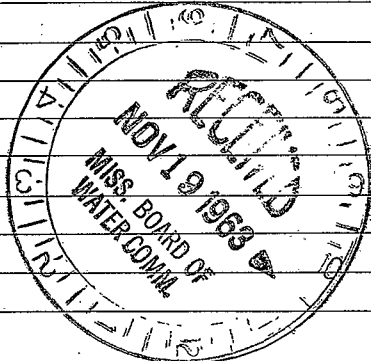

(Use Back Side)

Well No.

