

Lowndes
M 2001
2-68

MISSISSIPPI
BOARD OF WATER COMMISSIONERS
416 North State Street
Jackson, Mississippi 39201

WATER WELL DRILLERS LOG

Feb 19 68 Clardy Well Drilling Lowndes
date well completed firm name county well located

LANDOWNER: At Lowndes Lake
Well drilled for
4 Camp Houses
(mailing address)

description of formations encountered	from	to
Red Clay	0	50
Sandy blue rock	50	70
Blue rock	70	90
Sand	90	110
rock	111	
Sandy blue rock	111	130
Blue rock	130	136
Blue rock	136	190
Sand	190	194
Blue rock	194	245
Sand	245	250
Blue rock	250	275
Sand	275	285

WELL LOCATION: 17
sec. 11 T. 19 N R. 19 E
8 miles SE of Colo.
(distance) (direction) (nearest town)

WELL PURPOSE:
(home, irrigation, municipal, industrial)

WELL COMPLETION DATA:


- (1) diameter (inches) 4"
- (2) total depth (feet) 285'
- (3) static water level (feet) 80 below top of ground
- (4) casing 4" 136 1/2'
(material) (depth)
- _____ if telescope see back.
(size)
- (5) screen _____
(length) (depth to top)
- _____ (size) _____ (material)
- (6) pump 3/4 800 gph
(HP) (yield gpm)
- _____ (type power)
- (7) electric log No
(yes or no)
- _____ (organization running log)
- (8) how well bottom plugged _____

DRILLERS REMARKS:

JUL 15 1968
MISS. BOARD OF
WATER COM.

If well telescopes please sketch and show depths.

GROUND LEVEL

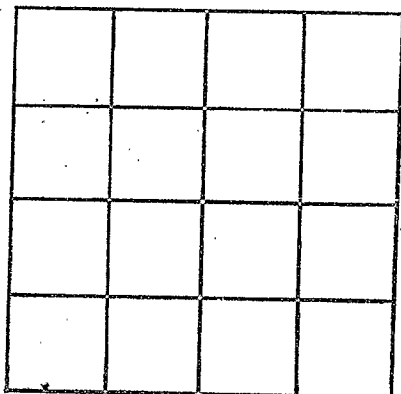

SECTION _____

Please indicate well location X.

ADDITIONAL INFORMATION

If more than one screen,
show locations of each on sketch.