

LOWNDES
M 7002
2/15/77

MISSISSIPPI
BOARD OF WATER COMMISSIONERS
416 North State Street
Jackson, Mississippi 39201

WATER WELL DRILLERS LOG

Feb. 15
date well completed

13L 77 ALLsup Drilling INC.
firm name

Lowndes
county well located

LANDOWNER: Miss JEWEL
Sobley Rt 8 Box 224
Columbus, MS. 39701
(mailing address)

WELL LOCATION:
sec 28 T 19 S R 17 W
10 miles S.E. of Columbus
(distance) (direction) (nearest town)

WELL PURPOSE: none
(home, irrigation, municipal, industrial)

WELL COMPLETION DATA:
(1) diameter (inches) 4" x 2"
(2) total depth (feet) 400'
(3) static water level (feet) _____ below top of ground.
(4) casing 4" plastic, 160' (material) (depth)
4" x 2" if telescope see back. (size)
(5) screen 80' 320' (length) (depth to top)
4" x 2" plastic (size) (material)
(6) pump 1/2 9 (HP) (yield gpm)
Electric (type power)
(7) electric log NO (yes or no)
(organization running log)
(8) how well bottom plugged CAP

| description of formations encountered | from | to |
|---------------------------------------|------|-----|
| TOP SOIL | 0 | 15 |
| HEAVY CLAY | 15 | 70 |
| GRAVEL | 70 | 151 |
| ROCK | 151 | 158 |
| MUCK SAND | 158 | 170 |
| MUCK SAND | 170 | 318 |
| MUCK SAND | 318 | 319 |
| SAND | 319 | 400 |


RECEIVED
JUL 5 - 1977

MISS. BD. OF WATER COMMISSIONERS

DRILLERS REMARKS:

If well telescopes please sketch and show depths.

GROUND LEVEL

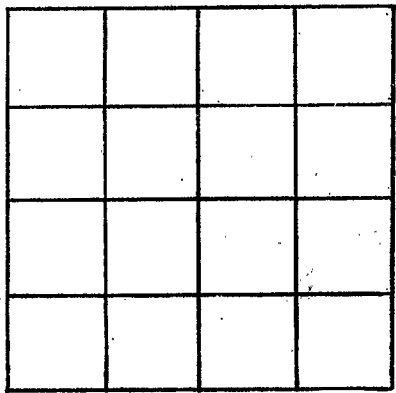

SECTION _____

Please indicate well location X.

ADDITIONAL INFORMATION

A series of horizontal lines for recording additional information.

If more than one screen, show locations of each on sketch.