

**MISSISSIPPI  
BOARD OF WATER COMMISSIONERS**  
416 North State Street  
Jackson, Mississippi 39201  
**WATER WELL DRILLERS LOG**

LOWNDES  
M 2004  
7-1-78

July 1, 19 78 Mid-South Drilling Co. Lowndes  
date well completed firm name county well located


LANDOWNER: <u>L. A. Straton</u>	description of formations encountered	from	to
	sand	115	125
<u>New Hope, MS</u> (mailing address)	clay	125	131
	sand	131	135
WELL LOCATION: sec <u>10</u> T <u>19</u> R <u>19</u> <u>E</u> <u>2</u> <u>SE</u> <u>Newhope</u> miles (distance) of (direction) (nearest town)	clay & sand	135	150
	sand	150	165
WELL PURPOSE: <u>home</u> (home, irrigation, municipal, industrial)			
WELL COMPLETION DATA: (1) diameter (inches) <u>4</u>			
(2) total depth (feet) <u>165</u>			
(3) static water level (feet) <u>80</u> <u>below</u> top of ground. <u>surface</u>			
(4) casing <u>PVC</u> , <u>80</u> (material) (depth) (size) If telescope see back.			
(5) screen <u>none</u> , (length) (depth to top) (size) (material)			
(6) pump <u>1/2</u> , <u>7</u> (HP) (yield gpm) <u>electric</u> (type power)			
(7) electric log <u>no</u> (yes or no) (organization running log)			
(8) how well bottom plugged <u>open</u>			
DRILLERS REMARKS:			

**RECEIVED**  
AUG 1 1978

MISS. BD. OF WATER COMM.

If well telescopes please sketch and show depths.

GROUND LEVEL

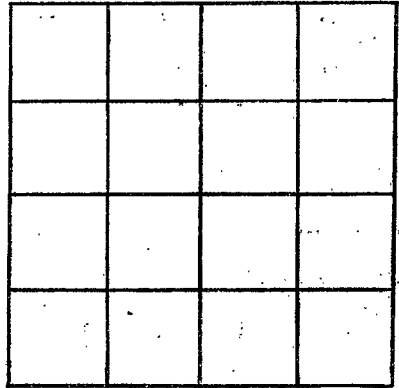

SECTION \_\_\_\_\_

Please indicate well location X.

ADDITIONAL INFORMATION

If more than one screen, show locations of each on sketch.