

LOWNDES  
 M 205  
 7-28-78

MISSISSIPPI  
 BOARD OF WATER COMMISSIONERS  
 416 North State Street  
 Jackson, Mississippi 39201  
 WATER WELL DRILLERS LOG

July 28, 1978 Mid-South Drilling Co. Lowndes  
 date well completed firm name county well located

LANDOWNER: Mrs. Opal Vava  
 P. O. Box 211  
 Brooksville, MS 39739  
 (mailing address)  
 WELL LOCATION:  
 sec. 10 T. 19 S. R. 10 E. 17W  
 2 miles SE of Newhope  
 (distance) (direction) (nearest town)

description of formations encountered	depth	
	from	to
clay	0	105
clay and sand	105	120
clay	120	135
clay & sand streaks	135	240
sand	240	250
clay	250	255

WELL PURPOSE: none  
 (home, irrigation, municipal, industrial)

WELL COMPLETION DATA:  
 (1) diameter (inches) 4  
 (2) total depth (feet) 255  
 (3) static water level (feet) 80 below top of ground.  
 (4) casing PVC 80 (material) (depth) If telescope see back.  
 (5) screen none (length) (depth to top) (size) (material)  
 (6) pump 1/2 (HP) 7 (yield gpm) electric (type power)  
 (7) electric log no (yes or no) (organization running log)  
 (8) how well bottom plugged open


RECEIVED  
 AUG 10 1978

MISS. BD. OF WATER COMM.

DRILLERS REMARKS:

If well telescopes please sketch and show depths.

GROUND LEVEL

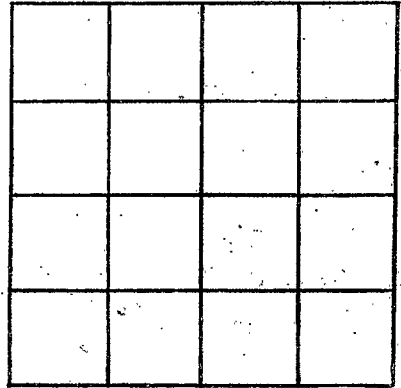

SECTION \_\_\_\_\_

Please indicate well location X.

ADDITIONAL INFORMATION

If more than one screen, show locations of each on sketch.