

LOWNDES

M 2006

6-14-78

MISSISSIPPI  
 BOARD OF WATER COMMISSIONERS  
 416 North State Street  
 Jackson, Mississippi 39201

WATER WELL DRILLERS LOG


June 14, 1978 Mid-South Drilling Co. Lowndes  
 date well completed firm name county well located

LANDOWNER: R. J. LeBlance	description of formations encountered	from	to
	clay	0	85
New Hope, MS	clay & sand streaks	85	165
(mailing address)	sand	165	170
WELL LOCATION:	clay	170	173
sec. 10 T 19 S R 19 E 17W	sand	173	175
2 miles south of Newhope	clay	175	176
(distance) (direction) (nearest town)	sand	176	183
WELL PURPOSE: home	clay	183	187
(home, irrigation, municipal, industrial)	sand	187	192
WELL COMPLETION DATA:	clay	192	210
(1) diameter (inches) 4	clay & sand streaks	210	225
(2) total depth (feet) 285	clay	225	233
(3) static water level (feet) 80 below top of ground.	sand	233	255
(4) casing PVC 80 (material) (depth)	clay	255	265
(size) If telescope see back.	sand	265	280
(5) screen none (length) (depth to top)	clay	280	285
(size) (material)			
(6) pump 1/2 (HP) 7 (yield gpm)			
electric (type power)			
(7) electric log no (yes or no)			
(organization running log)			
(8) how well bottom plugged open			
DRILLERS REMARKS:			

500  
 AUG 10 1978  
 MISS. BD. OF WATER COMMISSIONERS

If well telescopes please sketch and show depths.

GROUND LEVEL

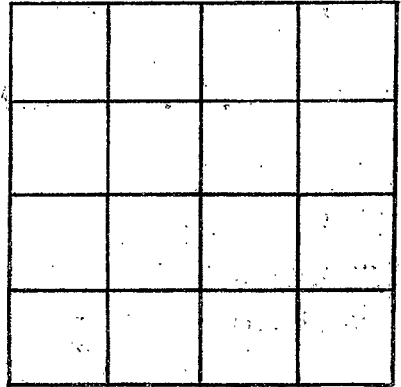

SECTION \_\_\_\_\_

Please indicate well location X.

ADDITIONAL INFORMATION

If more than one screen, show locations of each on sketch.