

**LOWNDES**  
**M 2008**  
**4-7-79**

**MISSISSIPPI**  
**BOARD OF WATER COMMISSIONERS**  
 416 North State Street  
 Jackson, Mississippi 39201

**WATER WELL DRILLERS LOG**

April 7 1979 Mid South Drilling Loundes  
 date well completed firm name county well located


LANDOWNER: <u>Mr. Atkins</u>	description of formations encountered	from	to
<u>Columbus MS 39701</u> (mailing address)	<u>clay</u>	<u>0</u>	<u>15</u>
<b>WELL LOCATION:</b> sec. <u>5</u> T <u>19</u> S R. <u>17</u> E <u>3</u> miles <u>SE</u> of <u>Newkops</u> (distance) (direction) (nearest town)	<u>sand &amp; gravel</u>	<u>15</u>	<u>25</u>
<b>WELL PURPOSE:</b> <u>home</u> (home, irrigation, municipal, industrial)	<u>clay</u>	<u>25</u>	<u>90</u>
<b>WELL COMPLETION DATA:</b>	<u>clay &amp; sand</u>	<u>90</u>	<u>135</u>
(1) diameter (inches) <u>4</u>	<u>clay</u>	<u>135</u>	<u>150</u>
(2) total depth (feet) <u>270</u>	<u>clay &amp; sand</u>	<u>150</u>	<u>255</u>
(3) static water level (feet) <u>60</u> below top of ground.	<u>clay</u>	<u>255</u>	<u>270</u>
(4) casing <u>PVC</u> , <u>75</u> (material) (depth)			
<u>4</u> (size) if telescope see back.			
(5) screen <u>none</u> (length) (depth to top)			
(size) (material)			
(6) pump <u>3/4</u> <u>10</u> (HP) (yield gpm)			
<u>electric</u> (type power)			
(7) electric log <u>no</u> (yes or no)			
<u>no</u> (organization running log)			
(8) how well bottom plugged <u>open</u>			
<b>DRILLERS REMARKS:</b>			

Miss. Board of Water Comm.

MAY 21 1979

If well telescopes please  
sketch and show depths.

GROUND LEVEL

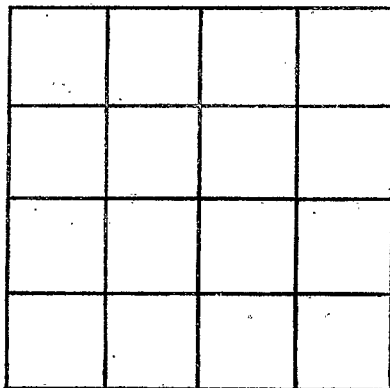

SECTION \_\_\_\_\_

Please indicate well location X.

ADDITIONAL INFORMATION

If more than one screen,  
show locations of each on sketch.