

Received

DNR

9/24/79

Louder
M 2009
9-6-79

MISSISSIPPI
BOARD OF WATER COMMISSIONERS
416 North State Street
Jackson, Mississippi 39201

WATER WELL DRILLERS LOG

9-6
date well completed


1979 Mid South Drilling
firm name

Louder
county well located

LANDOWNER	description of formations encountered	from	to
J.C. Mauldin			
Columbus MS (mailing address)	clay	0	70
	sand	70	75
WELL LOCATION: sec 22 T 19 N R 17 W 6 miles S of Col. (distance) (direction) (nearest town)	clay + sand	75	255
	sand	255	260
WELL PURPOSE: home (home, irrigation, municipal, industrial)	clay	260	268
WELL COMPLETION DATA:	sand	268	270
(1) diameter (inches) 4	clay	270	285
(2) total depth (feet) 285			
(3) static water level (feet) _____ below/above top of ground.			
(4) casing PVC, 120 (material), (depth), 4 (size) if telescope see back.			
(5) screen NO (length), (depth to top) _____ (size), _____ (material)			
(6) pump NO (HP), (yield gpm) _____ (type power) _____			
(7) electric log NO (yes or no) _____ (organization running log) NO			
(8) how well bottom plugged open			
DRILLERS REMARKS:			

If well telescopes please sketch and show depths.

GROUND LEVEL

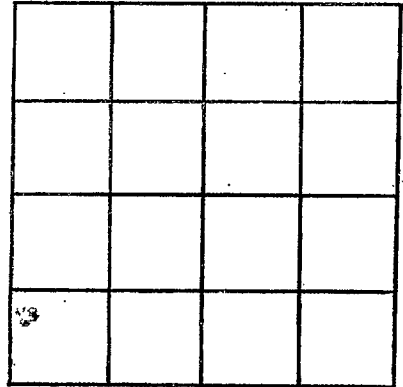

SECTION _____

Please indicate well location X.

ADDITIONAL INFORMATION

If more than one screen,
show locations of each on sketch.