

Lowndes

MISSISSIPPI  
BOARD OF WATER COMMISSIONERS  
416 North State Street  
Jackson, Mississippi 39201

WATER WELL DRILLERS LOG

May 29, 1980

Mid South Drilling Co.

Lowndes

date well completed

firm name

county well located

LANDOWNER: Arron Hill

description of formations encountered

from

to

Lake Lowndes

Columbus, MS 39701

(mailing address)

clay

0

10

sand and gravel

10

20

clay

20

105

clay and sand

105

135

clay

135

150

clay and sand

150

285

clay

285

300

WELL LOCATION:

Sec. 8 T. 19. S. R. 18 W. Col.  
6 miles SE of Col.  
(distance) (direction) (nearest town)

WELL PURPOSE: home  
(home, irrigation, municipal, industrial)

WELL COMPLETION DATA:

- (1) diameter (inches) 4
- (2) total depth (feet) 300
- (3) static water level (feet) 60 below top of ground. ~~above~~
- (4) casing PVC, 170 (depth), 4" (size) if telescope see back.
- (5) screen n/a (length), n/a (depth to top), n/a (size), n/a (material)
- (6) pump 2 (HP), 15 (yield gpm), electric (type power)
- (7) electric log no (yes or no), no (organization running log)
- (8) how well bottom plugged open

DEPT. OF NATURAL RESOURCES  
BUREAU OF LAND & WATER RESOURCES


JUL 14 1980

RECEIVED

DRILLERS REMARKS:

If well telescopes please sketch and show depths.

GROUND LEVEL

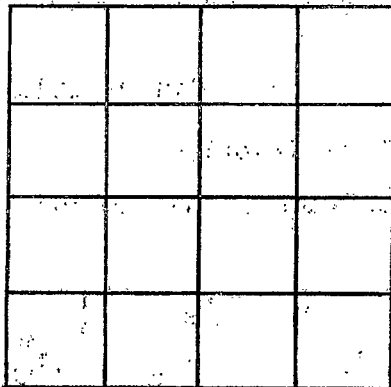

SECTION \_\_\_\_\_

Please indicate well location X.

ADDITIONAL INFORMATION

If more than one screen, show locations of each on sketch.