

LOWLANDS

M. 201
7/18/80

MISSISSIPPI
BOARD OF WATER COMMISSIONERS
416 North State Street
Jackson, Mississippi 39201

WATER WELL DRILLERS LOG

7-18 1980 date well completed
80 Martin S. Koffman & Saunders firm name
county well located

LANDOWNER: Melvin Anderson
Columbus MS.
(mailing address)

WELL LOCATION:
sec. 21 T. 19 N R. 17 W
S E
5 miles (distance) SE (direction) of Columbus (nearest town)

WELL PURPOSE: Home
(home, irrigation, municipal, industrial)

- WELL COMPLETION DATA:
- (1) diameter (inches) 4"
 - (2) total depth (feet) 300
 - (3) static water level (feet) 88' below top of ground.
 - (4) casing PVC, 135' (material) (depth)
4" (size) if telescope see back.
 - (5) screen None (length) (depth to top)
(size) (material)
 - (6) pump 3/4 12 (HP) (yield gpm)
E (type power)
 - (7) electric log _____ (yes or no)

(organization running log)

(8) how well bottom plugged after

DRILLERS REMARKS:

Description of formations encountered	from	to
<u>Yellow clay</u>	<u>0</u>	<u>32</u>
<u>Blue shale</u>	<u>32</u>	<u>123</u>
<u>Rock</u>	<u>123</u>	<u>124</u>
<u>Blue shale & sand</u>	<u>124</u>	<u>300</u>


DEPT. OF NATURAL RESOURCES
BUREAU OF LAND & WATER RESOURCES

AUG 11 1980

RECEIVED

If well telescopes please sketch and show depths.

GROUND LEVEL

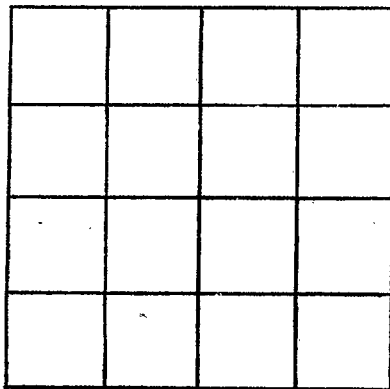

SECTION _____

Please indicate well location X.

ADDITIONAL INFORMATION

If more than one screen,
show locations of each on sketch.