

LOWNDES  
M 2012  
10-13-80

MISSISSIPPI  
 BOARD OF WATER COMMISSIONERS  
 416 North State Street  
 Jackson, Mississippi 39201

WATER WELL DRILLERS LOG

10-3 date well completed      1980 Alhsup Drilling INC. firm name      LOWNDES county well located

LANDOWNER: JAMES  
Montgomery  
Rt. 8, Box 275  
Columbus, MS. 39701  
 (mailing address)

description of formations encountered	from	to
Top Soil	0	3'
CLAY	3	13'
Red SAND & GRAVEL	13	52'
Lime Rock	52	118'
Muck	118	119'
2nd. SAND	119	320'

WELL LOCATION:  
 sec. 30 T. 19 S. R. 17 W.  
3 miles South of Columbus  
 (distance) (direction) (nearest town)

WELL PURPOSE: home  
 (home, irrigation, municipal, industrial)

- WELL COMPLETION DATA:
- (1) diameter (inches) 4" x 2"
  - (2) total depth (feet) 320'
  - (3) static water level (feet) 20' below top of ground.
  - (4) casing 4" PLASTIC, 140'  
 (material) (depth)
  - 4" x 2" if telescope see back.  
 (size)
  - (5) screen 20' 80' 240'  
 (length) (depth to top)
  - 4" x 2" PLASTIC  
 (size) (material)
  - (6) pump 3/4 20  
 (HP) (yield gpm)
  - Electric  
 (type power)
  - (7) electric log NO  
 (yes or no)

(organization running log)

(8) how well bottom plugged CAP

DRILLERS REMARKS:

DEPT. OF NATURAL RESOURCES  
 BUREAU OF LAND & WATER RESOURCES


DEC 10 1980

RECEIVED

If well telescopes please sketch and show depths.

GROUND LEVEL

140' 4"  
Casing

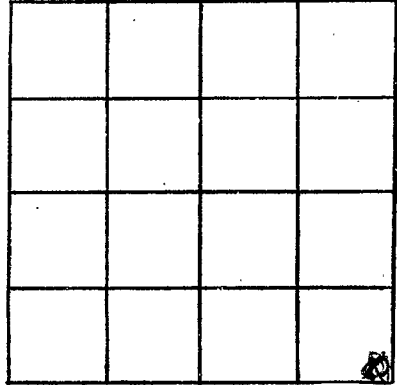

SECTION 30

Please indicate well location X.

ADDITIONAL INFORMATION

80' 2"  
~~140' 2"~~  
Casing  
100' 2"  
Commercial  
Screen

If more than one screen,  
show locations of each on sketch.