

LOWMEDES
M 2013

MISSISSIPPI
BOARD OF WATER COMMISSIONERS
416 North State Street
Jackson, Mississippi 39201

2-29-80
Feb. 29 1980

WATER WELL DRILLERS LOG

80 Martin S. Kirby

Lowndes Co., MS.

date well completed

firm name

county well located

LANDOWNER: Dan Meredith
Richardson Rd
Columbus, MS.
(mailing address)

description of formations encountered

from

to

yellow clay 0 52
blue shale 52 100

blue clay &
sand streaks 100 200

WELL LOCATION:

sec. 9 T 19 N R 13 E
2 miles SOUTH of NEW HOPE
(distance) (direction) (nearest town)

WELL PURPOSE: HOME
(home, irrigation, municipal, industrial)

WELL COMPLETION DATA: 3-3-80

- (1) diameter (inches) 20.4"
- (2) total depth (feet) 200'
- (3) static water level (feet) 68' below top of ground.
- (4) casing PVC, 100' (material) (depth)
4" if telescope see back. (size)
- (5) screen (length) (depth to top)
(size) 3/4 (material)
13 (yield gpm)
- (6) pump (HP) (type power) E-
- (7) electric log NO (yes or no)
(organization running log)
- (8) how well bottom plugged open


DEPT. OF NATURAL RESOURCES
BUREAU OF LAND & WATER

APR 16 1980
RECEIVED

DRILLERS REMARKS:

If well telescopes please sketch and show depths.

GROUND LEVEL

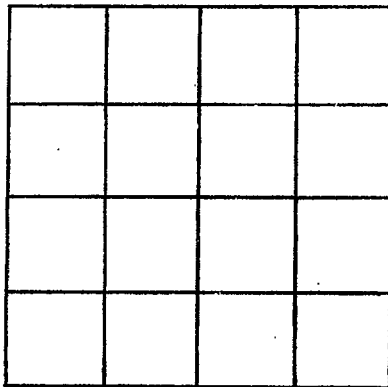

SECTION _____

Please indicate well location X.

ADDITIONAL INFORMATION

If more than one screen, show locations of each on sketch.