

MISSISSIPPI DEPARTMENT OF NATURAL RESOURCES

Bureau of Land and Water Resources

Southport Mall

P.O. Box 10631

Jackson, Mississippi 39209

WATER WELL DRILLERS LOG

Lowndes  
M 2014  
3-5-81

3-5 date well completed    81 Clardy Well Drilling firm name    Lowndes county well located

LANDOWNER: Ronnie West  
Columbus, Miss  
Lumberg Rd.  
(mailing address)

WELL LOCATION:  
sec. 21 T. 19 N. R. 12 E. 17 W  
6 1/2 miles SE of Col.  
(distance) (direction) (nearest town)

WELL PURPOSE: Home  
(home, irrigation, municipal, industrial)

WELL COMPLETION DATA:

- (1) diameter (inches) 4"
- (2) total depth (feet) 228'
- (3) static water level (feet) 68' below above top of ground.
- (4) casing PVC, 112'  
(material) (depth)  
(size) if telescope see back.
- (5) screen \_\_\_\_\_  
(length) (depth to top)  
(size) (material)
- (6) pump 1/2 750 gph  
(HP) (yield gpm)
- (type power)
- (7) electric log \_\_\_\_\_  
(yes or no)  
(organization running log)
- (8) how well bottom plugged \_\_\_\_\_

Description of formations encountered	from	to
Blue Clay	12	67
Black formation	67	69
Blue Clay	69	121
Sand	121	121 1/2
Clay	121 1/2	125
Sandy Strucks	125	132
Clay	132	139
Sand	139	140
Sandy Strucks	140	145
Sand	145	147
Rock	147	147 1/2
Sandy Strucks	147 1/2	172
Rock	172	175
Sand	175	180
Sandy Strucks	180	197
Sand	197	198
Sandy Strucks	198	200
Clay	200	212
Sandy	212	220
Clay	220	228


DEPT. OF NATURAL RESOURCES  
BUREAU OF LAND & WATER RESOURCES

APR 10 1981  
RECEIVED

DRILLERS REMARKS:

If well telescopes please  
sketch and show depths.

GROUND LEVEL

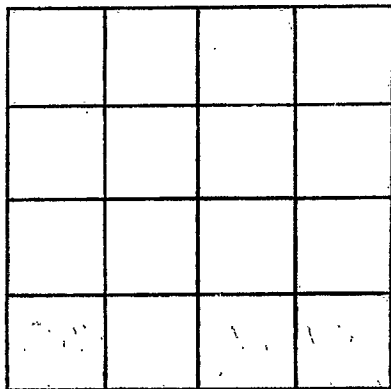

SECTION \_\_\_\_\_

Please indicate well location X.

ADDITIONAL INFORMATION

If more than one screen,  
show locations of each on sketch.