

ph - 318-7708

LOWMEDES
M 2016
5/22/81

MISSISSIPPI
BOARD OF WATER COMMISSIONERS
416 North State Street
Jackson, Mississippi 39201

WATER WELL DRILLERS LOG

5-22 date well completed
St Martin S. Ridgeway firm name
Lowmedes county well located

LANDOWNER: Mike Walker
spiny head
Columbus, MS, 39701
(mailing address)


description of formations encountered	from	to
red sand	0	27
Brown hard clay	27	52
Grey clay	52	90
Blue clay	90	154
blue clay & sand	154	243

WELL LOCATION:
sec. 11 T 19 N R 17 E
1/4 miles South of Lake Lowmedes
(distance) (direction) (nearest town)

WELL PURPOSE: HOME
(home, irrigation, municipal, industrial)

WELL COMPLETION DATA:


- (1) diameter (inches) 4"
- (2) total depth (feet) 243
- (3) static water level (feet) 118 below top of ground.
- (4) casing PVC, 129' (material) (depth)
(size) If telescope see back.
- (5) screen (length) (depth to top)
(size) (material)
- (6) pump 1/2 Sub. 15 (HP) (yield gpm)
E1 (type power)
- (7) electric log (yes or no)
(organization running log)
- (8) how well bottom plugged

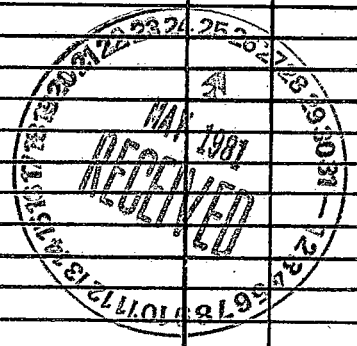

DRILLERS REMARKS: open

If well telescopes please sketch and show depths.

GROUND LEVEL

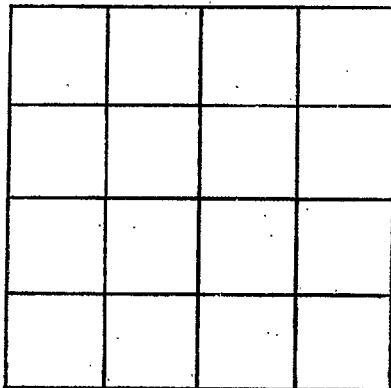

SECTION _____

Please indicate well location X.

ADDITIONAL INFORMATION

If more than one screen, show locations of each on sketch.