

MISSISSIPPI DEPARTMENT OF NATURAL RESOURCES

Bureau of Land and Water Resources

Southport Mall

P.O. Box 10631

Jackson, Mississippi 39209

WATER WELL DRILLERS LOG

Louder  
M 2018  
7-16-81

7-16 1981 Clardy Well Drilling Louder  
 date well completed firm name county well located

LANDOWNER: Cornel Mitchell  
508 11th St No.  
Columbus, Miss.  
 (mailing address)


WELL LOCATION: 17W  
2 sec. 3 T. 18 N. R. 19 E  
10 miles SE of Colo.  
 (distance) (direction) (nearest town)

WELL PURPOSE: home  
 (home, irrigation, municipal, industrial)

WELL COMPLETION DATA:

- (1) diameter (inches) 4"
- (2) total depth (feet) 173
- (3) static water level (feet) flowing below above top of ground.
- (4) casing PVC (material) (depth) \_\_\_\_\_  
 \_\_\_\_\_ if telescope see back. (size)
- (5) screen \_\_\_\_\_ (length) \_\_\_\_\_ (depth to top) \_\_\_\_\_  
 \_\_\_\_\_ (size) \_\_\_\_\_ (material)
- (6) pump 1/2 (HP) 900 gph (yield gpm)  
 \_\_\_\_\_ (type power)
- (7) electric log \_\_\_\_\_ (yes or no)  
 \_\_\_\_\_ (organization running log)
- (8) how well bottom plugged \_\_\_\_\_


description of formations encountered	from	to
Sandy	0	17
Blue clay	32	33
rock	33	34
Clay	34	71
Sand	71	72 1/2
Clay	72 1/2	74
Sand	74	76
Clay	76	78
Sand	78	80 1/2
Clay	80 1/2	113
Sand	113	115 1/2
rock	115 1/2	116
Sand	116	118
Clay	118	134
Sand	134	135
Clay	135	159
Sand	159	163
Clay	163	173

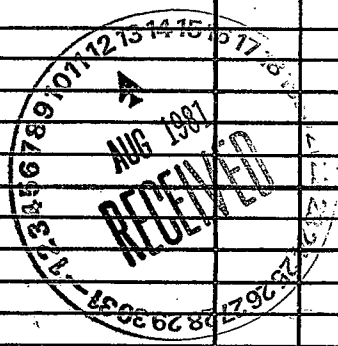

DRILLERS REMARKS: \_\_\_\_\_

If well telescopes please  
sketch and show depths.

GROUND LEVEL

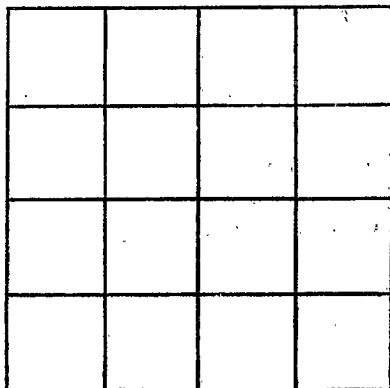

SECTION \_\_\_\_\_

Please indicate well location X.

ADDITIONAL INFORMATION

If more than one screen,  
show locations of each on sketch.