

MISSISSIPPI DEPARTMENT OF NATURAL RESOURCES

Bureau of Land and Water Resources

Southport Mall

P.O. Box 10631

Jackson, Mississippi 39209

WATER WELL DRILLERS LOG

LOWNDES
M 2019
7-23-81

7-23 date well completed 1981 Clardy Well Drilling Lowndes firm name county well located


LANDOWNER: Joe Hollis
Rt 4
Columbus, Miss.
(mailing address)

WELL LOCATION:
sec. 4 T. 19 N. R. 19 E. 17 W.
4 miles SE of Colo.
(distance) (direction) (nearest town)

WELL PURPOSE: home
(home, irrigation, municipal, industrial)

- WELL COMPLETION DATA:
- (1) diameter (inches) 4"
 - (2) total depth (feet) 282
 - (3) static water level (feet) 77 below above top of ground.
 - (4) casing PVC 97' (material) (depth)
if telescope see back.
(size)
 - (5) screen (length) (depth to top)
(size) (material)
 - (6) pump 1 1300 gph (HP) (yield gpm)
(type power)
 - (7) electric log (yes or no)
(organization running log)
 - (8) how well bottom plugged


description of formations encountered	from	to
Red Clay	1	18
blue clay (hard)	18	33
blue clay (soft)	33	38
blue clay (hard)	38	74
streaks of rock & clay	74	122
sand (fair)	122	131
blue clay	131	161
sand streaks	161	163
clay	163	187
sand streaks	187	190
clay	190	196
sand streaks	196	199
clay	199	227
sand streaks	227	257
good sand	257	270
(fair) sand	270	276
sand streaks	276	282

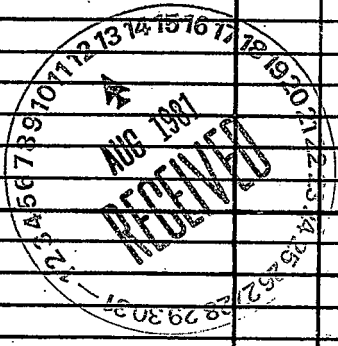

DRILLERS REMARKS:

If well telescopes please sketch and show depths.

GROUND LEVEL

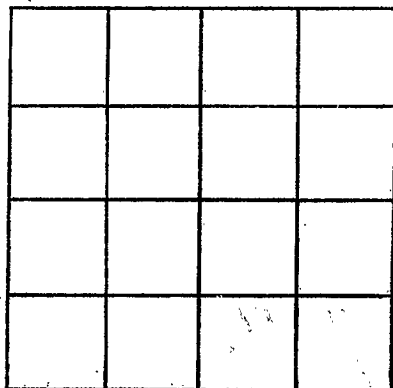

SECTION _____

Please indicate well location X.

ADDITIONAL INFORMATION

If more than one screen,
show locations of each on sketch.