

MISSISSIPPI DEPARTMENT OF NATURAL RESOURCES

Bureau of Land and Water Resources

Southport Mall

P.O. Box 10631

Jackson, Mississippi 39209

WATER WELL DRILLERS LOG

Lowndes
M 2021

2-11 1982 Clardy Well Drilling Lowndes
date well completed firm name county well located

LANDOWNER: Frances Dorrah
Rt 8 Box 307
Columbus, Miss.
(mailing address)

WELL LOCATION:
sec. 34 T. 19 N. R. 2 E. 17 W.
10 miles SE of Colosa
(distance) (direction) (nearest town)

WELL PURPOSE: home
(home, irrigation, municipal, industrial)

WELL COMPLETION DATA:

- (1) diameter (inches) 4"
- (2) total depth (feet) 201
- (3) static water level (feet) 65 below above top of ground.
- (4) casing PVC, 98',
(material) (depth)
4"
(size) if telescope see back.
- (5) screen _____
(length) (depth to top)
⊗
(size) (material)
- (6) pump 1/2 800
(HP) (yield gpm) gpm

(type power)
- (7) electric log _____
(yes or no)

(organization running log)
- (8) how well bottom plugged _____

description of formations encountered	from	to
red clay	0	42
blue clay	42	119
good sand	119	121
Clay	121	133
rock	133	
rock	135	
Clay	135	143
rock	143	
Clay	143	179
sand (good)	179	181
Clay	181	183
sand	183	200

DEPT. OF NATURAL RESOURCES
BUREAU OF LAND & WATER RESOURCES


APR 5 1982

RECEIVED

DRILLERS REMARKS:

If well telescopes please sketch and show depths.

GROUND LEVEL

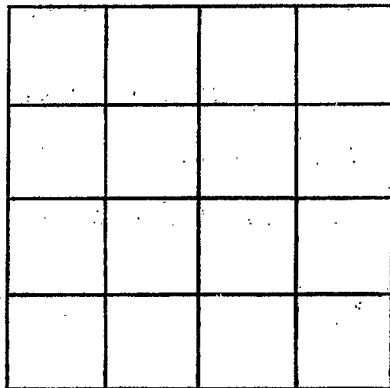

SECTION _____

Please indicate well location X.

ADDITIONAL INFORMATION

If more than one screen,
show locations of each on sketch.