

MISSISSIPPI DEPARTMENT OF NATURAL RESOURCES

Bureau of Land and Water Resources

Southport Mall

P.O. Box 10631

Jackson, Mississippi 39209

WATER WELL DRILLERS LOG

Lowndes  
M 0023

5-25 1982 Clardy Well Drilling Lowndes  
date well completed firm name county well located

LANDOWNER: John H. Clayton  
Richardson Rd.  
Columbus, Miss.  
(mailing address)

WELL LOCATION:  
sec. 9 T 19 N R 19 E  
4 miles SE of Colos.  
(distance) (direction) (nearest town)

WELL PURPOSE: home  
(home, irrigation, municipal, industrial)

WELL COMPLETION DATA:

- (1) diameter (inches) 4"
- (2) total depth (feet) 338'
- (3) static water level (feet) 118' below above top of ground.
- (4) casing PVC 160'  
(material) (depth)  
         if telescope see back.  
(size)
- (5) screen                    
(length) (depth to top)  
         (size)          (material)
- (6) pump 3/4 1200  
(HP) (yield gpm) gph  
elec  
(type power)
- (7) electric log no  
(yes or no)  
         (organization running log)
- (8) how well bottom plugged

description of formations encountered	from	to
red clay	0	18
gravel	18	33
clay	33	105
rock 2"	105	
clay	105	117
rock 4"		
sandy clay	117	138
rock 0	138	191
clay	191	193
sandy rock clay	193	205
sandy clay	205	221
good clay	221	241
rocky - sandy	241	250
light brown clay	250	261
gummy clay	261	274
rock 0	274	
sandy clay	274	310
blue clay	310	319
sandy clay	319	320
sand streaks	320	329
good sand	329	337
clay	337	338

DEPT. OF NATURAL RESOURCES  
BUREAU OF LAND & WATER RESOURCES


JUL - 1 1982

RECEIVED

DRILLERS REMARKS:

If well telescopes please sketch and show depths.

GROUND LEVEL

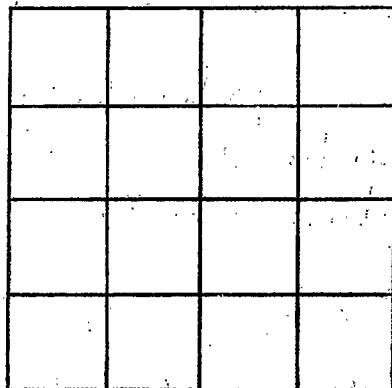

SECTION \_\_\_\_\_

Please indicate well location X.

ADDITIONAL INFORMATION

If more than one screen,  
show locations of each on sketch.