

Landowner  
M  
2026

MISSISSIPPI  
BOARD OF WATER COMMISSIONERS  
416 North State Street  
Jackson, Mississippi 39201

WATER WELL DRILLERS LOG

9-8-83 date well completed 1983 firm name Martin S. R. [unclear] county well located Landover

LANDOWNER: <u>Landover Camp</u>	description of formations encountered	from	to
<u>Rt 4 - Box 367</u>			
<u>Columbus MS 39701</u> (mailing address)	<u>clay</u>	<u>0</u>	<u>27</u>
WELL LOCATION: sec. <u>9</u> T. <u>19</u> N. R. <u>17</u> W. <u>2</u> miles <u>South</u> of <u>New Hope</u> (distance) (direction) (nearest town)	<u>Blue shale</u>	<u>27</u>	<u>107</u>
WELL PURPOSE: (home, irrigation, municipal, industrial)	<u>sand streaks</u>	<u>107</u>	<u>130</u>
WELL COMPLETION DATA: (1) diameter (inches) <u>4"</u>	<u>clay</u>	<u>130</u>	<u>139</u>
(2) total depth (feet) <u>221'</u>	<u>sand</u>	<u>139</u>	<u>148</u>
(3) static water level (feet) <u>25</u> below above top of ground.	<u>dark streaks of sand streaks</u>	<u>148</u>	<u>177</u>
(4) casing <u>PVC</u> , <u>135</u> (material) (depth)	<u>clay</u>	<u>177</u>	<u>205</u>
<u>        </u> if telescope see back. (size)	<u>sand</u>	<u>205</u>	<u>218</u>
(5) screen <u>        </u> <u>        </u> (length) (depth to top)			
<u>        </u> <u>        </u> (size) (material)			
(6) pump <u>1/2</u> <u>10</u> (HP) (yield gpm)			
<u>E</u> (type power)			
(7) electric log <u>        </u> (yes or no)			
<u>        </u> (organization running log)			
(8) how well bottom plugged <u>        </u>			
DRILLERS REMARKS: <u>        </u>			


DEPT. OF NATURAL RESOURCES  
BUREAU OF LAND & WATER RESOURCES

SEP 12 1983

RECEIVED

If well telescopes please sketch and show depths.

GROUND LEVEL

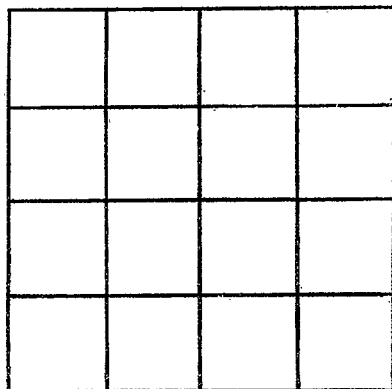

SECTION \_\_\_\_\_

Please indicate well location X.

ADDITIONAL INFORMATION

If more than one screen, show locations of each on sketch.