

Lowndes
M 2027

MISSISSIPPI
 BOARD OF WATER COMMISSIONERS
 416 North State Street
 Jackson, Mississippi 39201


WATER WELL DRILLERS LOG

August 2 1983 Mid South Drilling Company Lowndes
 date well completed firm name county well located

LANDOWNER: <u>Murrah's Chapel</u>		description of formations encountered	from	to
Rt. 8				
<u>Columbus, MS 39701</u>		sand and gravel	0	15
<u>(mailing address)</u>		clay	15	75
<u>WELL LOCATION:</u>		clay and sand	75	210
<u>sec 21 T 19 S R 17 E</u>				
<u>7 miles SE of Col.</u>				
<u>(distance) (direction) (nearest town)</u>				
<u>WELL PURPOSE: church use</u>				
<u>(home, irrigation, municipal, industrial)</u>				
<u>WELL COMPLETION DATA:</u>				
(1) diameter (inches) <u>XXX 4</u>				
(2) total depth (feet) <u>210</u>				
(3) static water level (feet) <u>40</u> below top of ground. XXXXX				
(4) casing <u>PVC</u> <u>120'</u>				
<u>(material) (depth)</u>				
<u>4"</u> if telescope see back:				
<u>(size)</u>				
(5) screen <u>none</u>				
<u>(length) (depth to top)</u>				
<u>(size) (material)</u>				
(6) pump <u>1/2</u> <u>10</u>				
<u>(HP) (yield gpm)</u>				
<u>electric</u>				
<u>(type power)</u>				
(7) electric log <u>no</u>				
<u>(yes or no)</u>				
<u>none</u>				
<u>(organization running log)</u>				
(8) how well bottom plugged <u>open</u>				
<u>DRILLERS REMARKS:</u>				

If well telescopes please sketch and show depths.

GROUND LEVEL

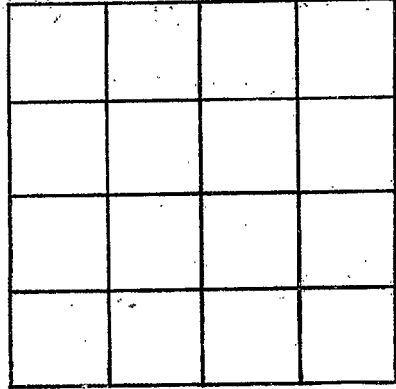

SECTION _____

Please indicate well location X.

ADDITIONAL INFORMATION

If more than one screen, show locations of each on sketch.