

MISSISSIPPI DEPARTMENT OF NATURAL RESOURCES

Bureau of Land and Water Resources

Southport Mall

P.O. Box 10631

Jackson, Mississippi 39209

WATER WELL DRILLERS LOG

Lowder
M 2028

10-17 Blardy Well Drilling Lowder
date well completed firm name county well located

LANDOWNER: L.A. Graver
Rt 8 Box 373
Columbus, Miss.
(mailing address)

WELL LOCATION:
sec. 36 T. 19 N. R. 18 W.
7 1/2 miles So of Co. Co.
(distance) (direction) (nearest town)

WELL PURPOSE: Home
(home, irrigation, municipal, industrial)

WELL COMPLETION DATA:

- (1) diameter (inches) 4"
- (2) total depth (feet) 202'
- (3) static water level (feet) 16' below above top of ground.
- (4) casing PVC, 72'
(material) (depth)
4"
(size) if telescope see back.
- (5) screen 50'
(length) (depth to top)
2", PVC
(size) (material)
- (6) pump 1/2 850
(HP) (yield gpm) gph
elec.
(type power)
- (7) electric log no
(yes or no)
(organization running log)
- (8) how well bottom plugged

description of formations encountered	from	to
red clay & sand	0	10
sand & gravel	10	38
blue clay	38	45 1/2
rock	45 1/2	46
blue clay	46	65
rock	65	
good blue clay	65 1/2	91
sandy	91	94
hard blue clay	94	108
sandy clay	108	112
good sand	112	118
rock	118	
sand	118 1/2	123
sandy clay	123	125
hard blue clay	125	139 1/2
rock	139 1/2	141
hard blue clay	141	142 1/2
rock	142 1/2	143
sandy clay	143	146
rock	146	
sandy clay	146 1/2	154 1/2
rock	154 1/2	
sandy clay	155	164
hard brown clay	164	202

DEPT. OF NATURAL RESOURCES
BUREAU OF LAND & WATER RESOURCES

DEC - 7 1988

RECEIVED


DRILLERS REMARKS:

If well telescopes please sketch and show depths.

GROUND LEVEL

72' 4"

50' screen
85' 0"

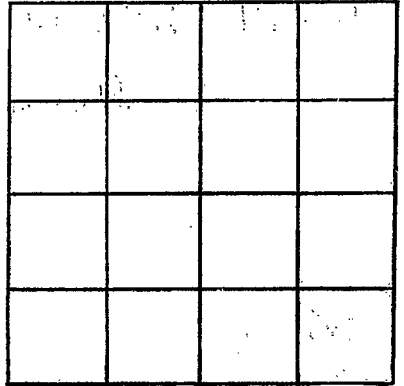

SECTION _____

Please indicate well location X.

ADDITIONAL INFORMATION

If more than one screen, show locations of each on sketch.