

MISSISSIPPI

BOARD OF WATER COMMISSIONERS

416 North State Street

Jackson, Mississippi 39201

WATER WELL DRILLERS LOG

Lowndes
M 2034

August 20 19 84 Mid Southdrilling Company Lowndes
date well completed firm name county well located

LANDOWNER: Terry E. Moore	description of formations encountered	from	to
P. O. Box 63			
Steens, MS 39766 (mailing address)	clay	0	12
	sand and gravel	12	20
	clay	20	90
	clay and sand	90	270
WELL LOCATION: sec. <u>10</u> T. <u>19</u> R. <u>17W</u> S E W <u>5</u> miles <u>SE</u> of <u>Columbus</u> (distance) (direction) (nearest town)			
WELL PURPOSE: <u>home</u> (home, irrigation, municipal, industrial)			
WELL COMPLETION DATA:			
(1) diameter (inches) <u>4"</u>			
(2) total depth (feet) <u>270'</u>			
(3) static water level (feet) <u>70'</u> <u>below</u> above top of ground.			
(4) casing <u>PVC</u> <u>170'</u> (material) (depth)			
<u>4"</u> (size) If telescope see back.			
(5) screen <u>none</u> (length) (depth to top)			
(size) (material)			
(6) pump <u>1/2</u> <u>10</u> (HP) (yield gpm)			
<u>electric</u> (type power)			
(7) electric log <u>no</u> (yes or no)			
<u>none</u> (organization running log)			
(8) how well bottom plugged <u>open</u>			
DRILLERS REMARKS:			


DEPT. OF NATURAL RESOURCES
BUREAU OF LAND & WATER RESOURCES

OCT - 1 1984

RECEIVED

If well telescopes please sketch and show depths.

GROUND LEVEL

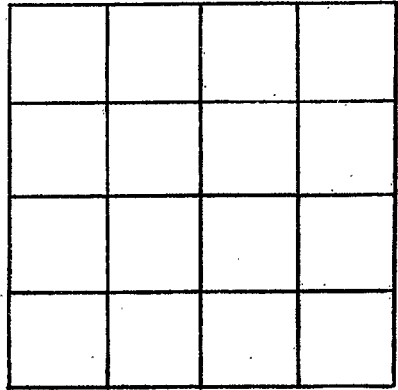

SECTION _____

Please indicate well location X.

ADDITIONAL INFORMATION

If more than one screen,
show locations of each on sketch.