

Lowndes  
M  
2035

MISSISSIPPI DEPARTMENT OF NATURAL RESOURCES  
 Bureau of Land and Water Resources  
 Southport Mall  
 P.O. Box 10631  
 Jackson, Mississippi 39209  
**WATER WELL DRILLERS LOG**

9-26-84 date well completed Clardy Well Drilling firm name Lowndes county well located

LANDOWNER: Rudy West  
110 Ala.  
Columbus, Ms.  
 (mailing address)

WELL LOCATION:  
 sec. 10 T. 19 N. R. 17 W.  
5 miles SE of Colo.  
 (distance) (direction) (nearest town)

WELL PURPOSE: home  
 (home, irrigation, municipal, industrial)

WELL COMPLETION DATA:

- (1) diameter (inches) 4"
- (2) total depth (feet) 328
- (3) static water level (feet) 18' below above top of ground.
- (4) casing PVC 81'  
 (material) (depth)  
4" if telescope see back.  
 (size)
- (5) screen \_\_\_\_\_  
 (length) (depth to top)  
 (size) (material)
- (6) pump 1/2 900 gph  
 (HP) (yield/gpm)  
elec  
 (type power)
- (7) electric log no  
 (yes or no)  
 \_\_\_\_\_  
 (organization running log)
- (8) how well bottom plugged \_\_\_\_\_

description of formations encountered	from	to
sandy	0	10
blue clay	10	15
sandy clay	15	18
good blue clay	18	75
rock	75	75 1/2
good clay	75 1/2	108
rock	108	109
good clay	109	115
sandy clay	115	119
good clay	119	144
sandy clay	144	156
hard clay	156	160
rock	160	160 1/2
hard clay	160 1/2	187
sand	187	190
hard clay	190	194
sand	194	198
hard clay	198	209
sand	209	227
hard clay	227	228

MISSISSIPPI DEPARTMENT OF NATURAL RESOURCES  
 BUREAU OF LAND & WATER RESOURCES


OCT 28 1984

RECEIVED

DRILLERS REMARKS: \_\_\_\_\_

If well telescopes please sketch and show depths.

GROUND LEVEL

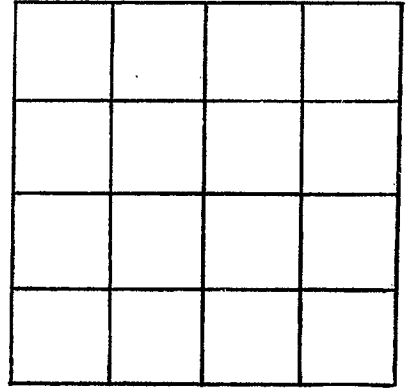

SECTION \_\_\_\_\_

Please indicate well location X.

ADDITIONAL INFORMATION

If more than one screen,  
show locations of each on sketch.