

MISSISSIPPI DEPARTMENT OF NATURAL RESOURCES

Bureau of Land and Water Resources

Southport Mall

P.O. Box 10631

Jackson, Mississippi 39209

WATER WELL DRILLERS LOG

LOWNDES
M
7048

4/15/86 19 Clardy Well Drilling Lowndes
 date well completed firm name county well located

LANDOWNER: Edwina Fulton
Oswalt Rd.
Columbus, Miss
 (mailing address)

WELL LOCATION:
 sec. 5 T. 19 N. R. 17 E. 17 W
3 miles SW of Colusa
 (distance) (direction) (nearest town)

WELL PURPOSE: home
 (home, irrigation, municipal, industrial)

WELL COMPLETION DATA:

(1) diameter (inches) 4"

(2) total depth (feet) 242'

(3) static water level (feet) 55 below top of ground.

(4) casing PVC 150'
 (material) (depth)
4"
 (size) If telescope see back.

(5) screen _____
 (length) (depth to top)
 (size) (material)

(6) pump 3/4 1000 gph.
 (HP) (yield gpm)

elec.
 (type power)

(7) electric log no
 (yes or no)

(organization running log)

(8) how well bottom plugged _____

description of formations encountered	from	to
sand & gravel	0	13
clay	13	42
sandy clay	42	64 1/2
rock	64 1/2	65
sandy clay	65	66
rock 4"		
sandy, rocky clay	66	82
sm. rock		
sandy, rocky clay	82	120
tan clay	120	128
tan. rock		
clay	128	130
sm. rock		
clay	130	132 1/2
sm. rock	132 1/2	138
hard clay	138	164
sm. rock		
hard clay	164	171 1/2
sandy clay	171 1/2	173 1/2
sm. rock		
hard clay	173 1/2	180
hard rock 4"		
clay	180	183
sm. rock		
sandy clay	183	187
rock 2"		
clay	187	189
rock 2"	189	189
clay	189	205
sandy streaks	205	215
clay	215	220
sandy streaks	220	222
clay	222	233
clay	233	242


MAY 22 1986

DRILLERS REMARKS:

Department of Natural Resources
 Bureau of Land & Water Resources

If well telescopes please sketch and show depths.

GROUND LEVEL

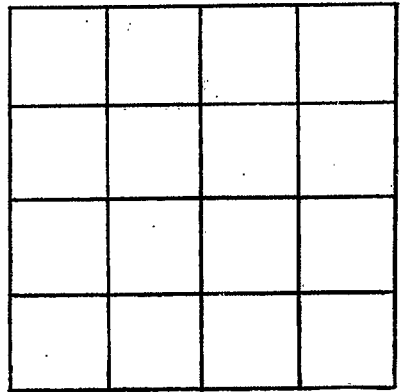

SECTION _____

Please indicate well location X.

ADDITIONAL INFORMATION

If more than one screen,
show locations of each on sketch.