

MISSISSIPPI DEPARTMENT OF ENVIRONMENTAL QUALITY

Office of Land and Water Resources

P. O. Box 10631
Jackson, MS 39289-0631
WATER WELL DRILLERS LOG

COUNTY WELL LOCATED
Grounded

WELL NUMBER 12066 CODED

DATE WELL COMPLETED
10/18/93

PERMIT NUMBER

NAME OF DRILLING FIRM
Clardy Well Columbus, Ind

NAME & MAILING ADDRESS OF LANDOWNER
John Gore
Yorkville Rd.
Columbus, Ind

WELL LOCATION: SEC 5 TOWNSHIP 19 S RANGE 17 W

DISTANCE 3 Miles DIRECTION S.E. of NEAREST TOWN Columbus

OTHER LANDMARK

WELL PURPOSE: Home, Irrigation, Municipal, Industrial, Fish Pond, etc.
Home

PUMP DATA

PUMP TYPE (Circle One):
Submersible Turbine, Jet, Flowing Well,
Other (Describe)

POWER TYPE (Circle One):
Electric Tractor, Diesel, Gasoline, Butane,
Other (Describe) H/P 1

Pump Capacity (GPM) 900 No. of Stages 15 Setting Depth 180 FT.

PUMP TEST
Well yielded _____ GPM with
a drawdown of _____ ft.
after _____ hours of pumping

WELL DATA

Well Depth <u>272</u>	Casing Diameter (In.) <u>4"</u>	Casing Length (Ft.) <u>190'</u>
Type of Casing <u>PVC</u>	Hole Depth <u>127 1/2</u>	Depth to Static Water Level

TYPE OF COMPLETION: (Circle One or More):
Gravel Packed, Underreamed, Telescoped,
Natural Development, Open Hole, Other
(Describe)

LOG DATA

TYPE OF LOG RUN (Circle One):
No Log Run, Electric, Gamma Ray, Density, Sonic, Neutron,
Other (Describe)

Name of Organization Running Log

WELL GROUTED TO A DEPTH OF _____ FEET
Type Grout (circle one): Cement, Bentonite, or Mix

GEOLOGIC DATA (Office Use Only)

Surface Elev.	Geologic Unit	Grout Thickness	Depth to Top
Subs. SWL	Date	Analysis	Acquired Test

SCREEN DATA

Diameter - Inches <u>2"</u>	Length - Feet <u>40'</u>	Slot Size - Inches <u>.013</u>
Screen Type <u>PVC</u>	Depth to Bottom - Feet	

Driller's Remarks


OCT 22 1993

Dept. of Environmental Quality
Office of Land & Water Resources

DESCRIPTION OF FORMATIONS ENCOUNTERED	FROM	TO	FORMATIONS (Continued)	FROM	TO
Red clay	0	22	Sandy clay	182	185
Gravel	22	38	Fine clay	185	188 1/2
Red sandy clay	38	42	Sandy clay	188 1/2	190
Blue clay	42	62	Clay + rock	190	210
Sandy clay	62	88	Rocky sand etc.	210	222
Clay	88	110	Sandy clay	222	231
Sandy clay	110	166 1/2	Rocky sand etc.	231	236
Rock	166 1/2	168	Sandy clay	236	242
Sandy clay + rock	168	169 1/2	Sand	242	270
Fine clay	169 1/2	170 1/2	Clay	270	272
Clay + rock	170 1/2	182			

IF MORE SPACES NEEDED, USE BACK

If well telescopes please sketch and show depths.

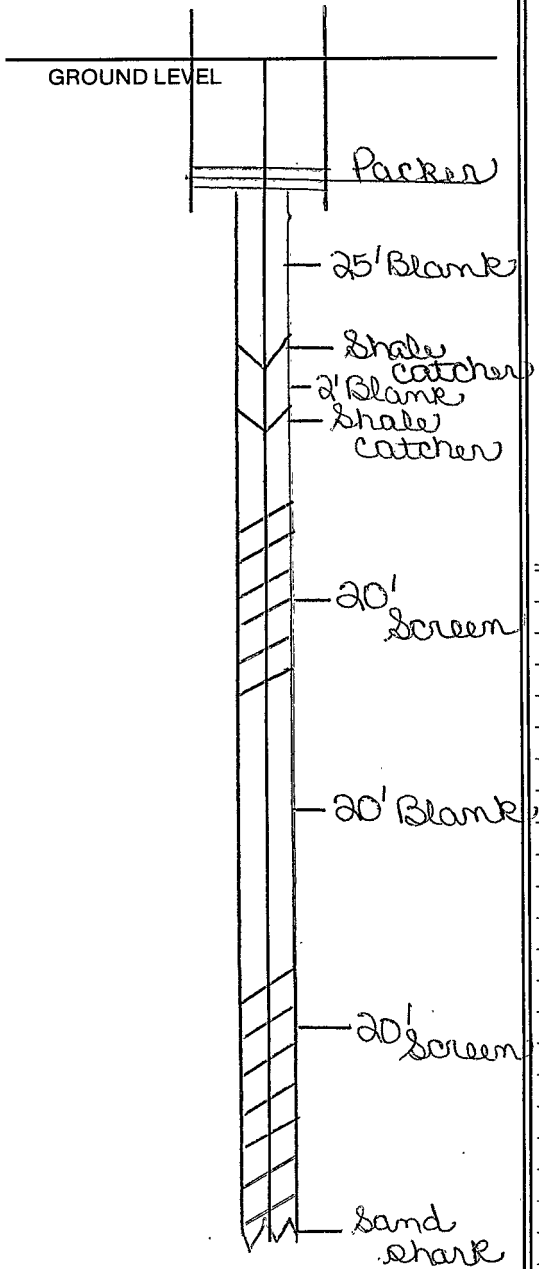

SECTION _____

Please indicate well location X.

ADDITIONAL INFORMATION

If more than one screen, show location of each on sketch.