

SE SESW 28 17N 16E

E/29 27

Louder  
N 23  
9-67  
U.S.G.S.

MISSISSIPPI  
 BOARD OF WATER COMMISSIONERS  
 416 North State Street  
 Jackson, Mississippi 39201

CODED

WATER WELL DRILLERS LOG

September, 1967 Herndon-Hornum Well Supply Louder  
 date well completed firm name county well located

LANDOWNER	description of formations encountered	from	to
<u>Crawford</u>	Surface clay	0	2
<u>Water Assoc.</u>	White clay (lime rock)	2	1440
<u>Crawford Miss</u> (mailing address)	Blue clay	1446	1470
WELL LOCATION:	Light sandy clay	1600	1780
sec. <u>28</u> T. <u>17</u> N R. <u>16</u> E	White chalk	780	905
SE 1/4 SE 1/4 SW 1/4	Light sand (Stratog shale)	905	1005
(distance) miles (direction) of (nearest town)	Sand	1005	1068
WELL PURPOSE: <u>Community</u> (home, irrigation, municipal, industrial)	Shale	1068	1082
WELL COMPLETION DATA:	Sand	1082	1120
(1) diameter (inches) <u>8"</u>	sand with streaks of shale	1120	1152
(2) total depth (feet) <u>1255'</u>	Sand	1152	1175
(3) static water level (feet) <u>113</u> below above top of ground.	Runy clay	1175	1210
(4) casing <u>Steel</u> , <u>1154'</u> (material) (depth)	Sand	1210	1255
<u>8"</u> (size) if telescope see back.	Bottom	1255	
(5) screen <u>50'</u> , <u>1125</u> (length) (depth to top)			
<u>4"</u> , <u>304 Stainless Steel</u> (size) (material)			
(6) pump <u>15</u> , <u>131.5</u> (HP) (yield gpm)			
<u>electric</u> (type power)			
(7) electric log <u>Yes</u> (yes or no)			
<u>U.S.G.S.</u> (organization running log)			
(8) how well bottom plugged <u>B/W</u>			
DRILLERS REMARKS:			

APR 30 1969  
 MISS. Bd. of  
 WATER COMMISSIONERS

(X)

If well telescopes please sketch and show depths.

GROUND LEVEL

11.5 ft  
9 8"  
casing



2 1/2" pipe

4" casing

50' of 4"  
screen

Ground wall

Top of screen  
1/25'

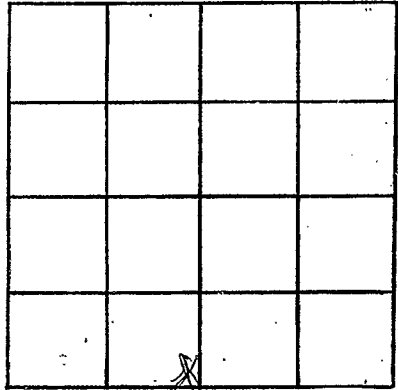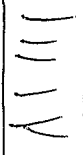

SECTION 28

Please indicate well location X.

ADDITIONAL INFORMATION

If more than one screen, show locations of each on sketch.