

Lowndes
N 24
6-8-69

MISSISSIPPI
BOARD OF WATER COMMISSIONERS
416 North State Street
Jackson, Mississippi 39201

WATER WELL DRILLERS LOG

June 8 1969 HERMAN ECHOLS Lowndes
date well completed firm name county well located

LANDOWNER:
Magnolia Woods
Carpenter, Miss
(mailing address)

description of formations encountered	from	to
	Red Clay Chalk Hard Rock Sand & Rocks	0 15 326 328

WELL LOCATION:
sec. 2 T. 17 N R. 16 E
S W
3 1/2 miles South of Corteva
(distance) (direction) (nearest town)

WELL PURPOSE:
(home, irrigation, municipal, industrial)

- WELL COMPLETION DATA:
- (1) diameter (inches) 4
 - (2) total depth (feet) 462
 - (3) static water level (feet) 80 below top of ground.
 - (4) casing 4" 21' (material) (depth)
 - (size) if telescope see back.
 - (5) screen none (length) (depth to top)
 - none (size) (material)
 - (6) pump 1/2 10 (HP) (yield gpm)
 - Elect (type power)
 - (7) electric log no (yes or no)
 - (organization running log)
 - (8) how well bottom plugged open


JUN 19 1969

MISS. BD. OF
STATE COM..

DRILLERS REMARKS:

If well telescopes please sketch and show depths.

GROUND LEVEL

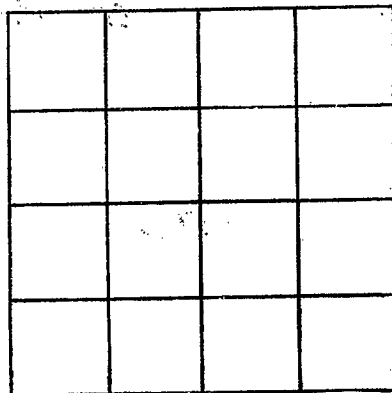

SECTION _____

Please indicate well location X.

ADDITIONAL INFORMATION

If more than one screen,
show locations of each on sketch.