

LOWNDES
N 28
9-15-72

MISSISSIPPI
 BOARD OF WATER COMMISSIONERS
 416 North State Street
 Jackson, Mississippi 39201

WATER WELL DRILLERS LOG

CODED

9-15-72 19 Herman Echols Lowndes
 date well completed firm name county well located

LANDOWNER: <u>Sanders Mc Gee</u>	description of formations encountered	from	to
<u>Crawford, Miss -</u> (mailing address)	<u>Top Soil</u> <u>Chalk</u> <u>Sand & Rock</u>	<u>0</u> <u>1'</u> <u>535</u>	<u>1'</u> <u>535</u> <u>675</u>
WELL LOCATION: sec. <u>7</u> T. <u>17</u> N R. <u>16</u> E <u>4</u> miles <u>NW</u> of <u>Crawford</u> (distance) (direction) (nearest town)			
WELL PURPOSE: <u>Home</u> (home, irrigation, municipal, industrial)			
WELL COMPLETION DATA:			
(1) diameter (inches) <u>5"</u>			
(2) total depth (feet) <u>675</u>			
(3) static water level (feet) <u>150</u> below above-top of ground.			
(4) casing <u>21' 5" Casing</u> (material) (depth)			
_____ if telescope see back. (size)			
(5) screen _____ (length) (depth to top)			
_____ (size) _____ (material)			
(6) pump <u>Rod Pump</u> <u>3 1/2 Gal/min</u> (HP) (yield gpm)			
<u>Elec</u> (type power)			
(7) electric log <u>No</u> (yes or no)			
_____ (organization running log)			
(8) how well bottom plugged _____			
DRILLERS REMARKS:			


CODED

NOV 20 1972

MISS. BD. OF WATER COMMISSIONERS

If well telescopes please sketch and show depths.

GROUND LEVEL

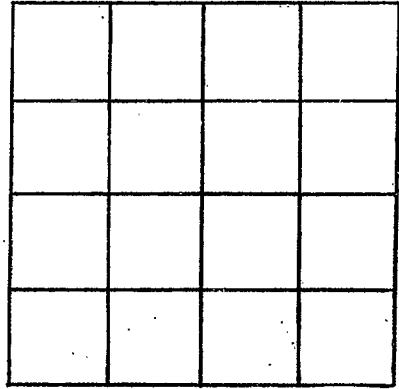

SECTION _____

Please indicate well location X.

ADDITIONAL INFORMATION

A series of horizontal lines for recording additional information, starting below the 'ADDITIONAL INFORMATION' header and extending to the bottom of the page.

If more than one screen, show locations of each on sketch.