

LOWNDES

N33

10-12-73

MISSISSIPPI
 BOARD OF WATER COMMISSIONERS
 416 North State Street
 Jackson, Mississippi 39201

CODED

WATER WELL DRILLERS LOG

10/12

1973

Norman Ebbels

Fauquier

date well completed

firm name

county well located

LANDOWNER: Mark M. Lay

description of formations encountered

from

to

H5 South

Red clay
chalk

0 3

Artesia, Miss
(mailing address)

3 500

Sand clay

500 800

WELL LOCATION:

sec. 4 1/2 T 17 N R 16 E
S W

4 miles South of Artesia
(distance) (direction) (nearest town)

WELL PURPOSE: Home
(home, irrigation, municipal, industrial)

WELL COMPLETION DATA:

- (1) diameter (inches) 5
- (2) total depth (feet) 800
- (3) static water level (feet) 120 below top of ground
- (4) casing 21' 5" Casings
(material) (depth)

CODED

(size) if telescope see back.

(5) screen (length) (depth to top)

(size) (material)

(6) pump 3/4 (HP) 10 (yield gpm)

E bit (type power)

(7) electric log (yes or no)

(organization running log)


(8) how well bottom plugged

JAN 2

MISS. Bd. of WATER COMMISSIONERS

DRILLERS REMARKS:

If well telescopes please sketch and show depths.

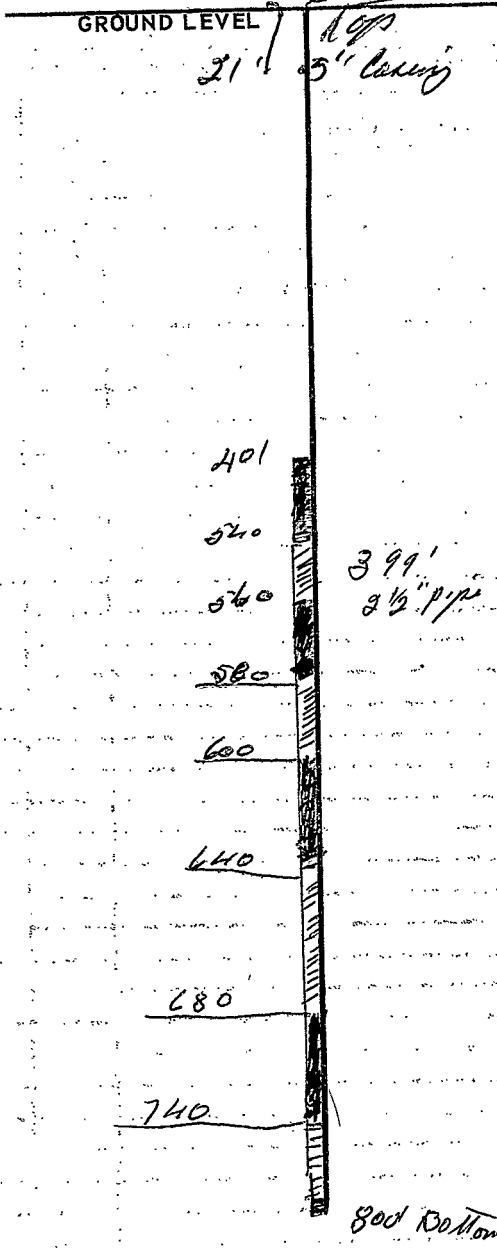

SECTION _____

Please indicate well location X.

ADDITIONAL INFORMATION

If more than one screen, show locations of each on sketch.