

LOWNDES

N37

9-11-74

MISSISSIPPI BOARD OF WATER COMMISSIONERS  
416 North State Street  
Jackson, Mississippi 39201

WATER WELL DRILLERS LOG

CODED

9/11 1974 HERMAN E CHOLS LOWNDES  
date well completed firm name county well located

LANDOWNER: Clark Ginters

description of formations encountered

from to

Carters, Miss

Top Soil

0 12

Clay

12 150

Sand & Gravel

150 380

(mailing address)

WELL LOCATION:

sec. 18 T. 17(N) S R. 16(E) W

5 miles E of Carters  
(distance) (direction) (nearest town)


WELL PURPOSE:

(home, irrigation, municipal, industrial)

WELL COMPLETION DATA:

- (1) diameter (inches) 5"
- (2) total depth (feet) 380
- (3) static water level (feet) 79 below top of ground.
- (4) casing 2.2' casing (material) (depth)
- (size) If telescope see back.
- (5) screen (length) (depth to top)
- (size) (material)
- (6) pump 1/2 (HP) 10 (yield gpm)
- ELECT (type power)
- (7) electric log (yes or no)
- (organization running log)
- (8) how well bottom plugged

CODED

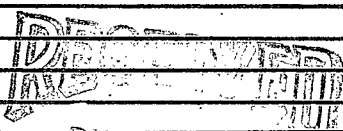


DEC 19 1974

DRILLERS REMARKS:

MISS. BD. OF WATER COMMISSIONERS

If well telescopes please sketch and show depths.

GROUND LEVEL

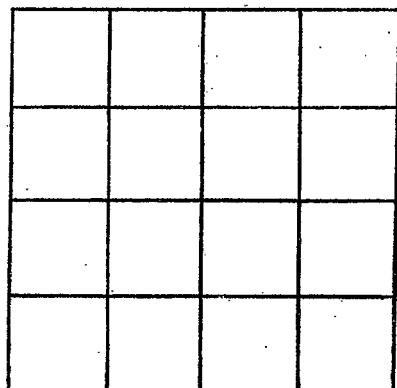

SECTION \_\_\_\_\_

Please indicate well location X.

ADDITIONAL INFORMATION

If more than one screen, show locations of each on sketch.