

LOWNDES

N 38

11-15-74

MISSISSIPPI BOARD OF WATER COMMISSIONERS 416 North State Street Jackson, Mississippi 39201

CODED

WATER WELL DRILLERS LOG

12/15/74 date well completed

1974

Norman E. Chubb firm name

LOWNDES county well located

LANDOWNER:

Robert Fortenberry

Ortman, Miss (mailing address)

WELL LOCATION:

sec. 17 T. 17 (N) R. 16 (E) S W

2 1/2 miles NORTH of Crawdad (distance) (direction) (nearest town)

WELL PURPOSE:

(home, irrigation, municipal, industrial)

WELL COMPLETION DATA:

- (1) diameter (inches) 5"
(2) total depth (feet) 700'
(3) static water level (feet) 140' below top of ground.
(4) casing 5" steel, 21' (material) (depth)

(size) if telescope see back.

- (5) screen (length) (depth to top)

(size) (material)

- (6) pump 3/4 (HP) 100 gpm (yield gpm)

E. Chubb (type power)

- (7) electric log no (yes or no)

(organization running log)

- (8) how well bottom plugged 0

description of formations encountered

from to

Sand & clay 0 9
Clay 9 560
Sand & Rock 560 700


CODED

21' 5" casing

Bottom casing 1400'
100' with slots

Sand

700'

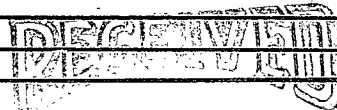


JAN 16 1975

DRILLERS REMARKS:

If well telescopes please sketch and show depths.

GROUND LEVEL

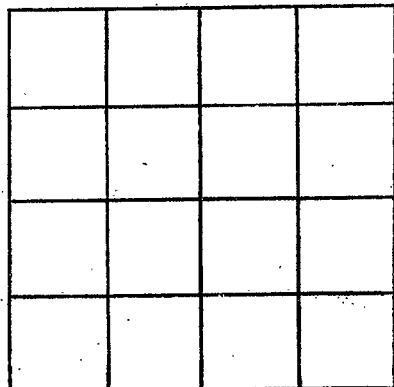

SECTION _____

Please indicate well location X.

ADDITIONAL INFORMATION

If more than one screen, show locations of each on sketch.