

Lowndes
N 200
7-14-75

MISSISSIPPI
 BOARD OF WATER COMMISSIONERS
 416 North State Street
 Jackson, Mississippi 39201

WATER WELL DRILLERS LOG

7/14 1975 Norman Ethel Lowndes
 date well completed firm name county well located

LANDOWNER: Franklin Telephone Co
45 South
Centers, Miss
 (mailing address)

description of formations encountered	from	to
<u>Chert</u>	<u>0</u>	<u>180</u>
<u>Sand</u>	<u>180</u>	<u>770</u>


WELL LOCATION:
 sec. 5 T. 17 N. R. 14 E. 13E
3 miles South of Centers
 (distance) (direction) (nearest town)

WELL PURPOSE:
 (home, irrigation, municipal, Industrial)

- WELL COMPLETION DATA:
- (1) diameter (inches) 5
 - (2) total depth (feet) 770
 - (3) static water level (feet) 100 below above top of ground.
 - (4) casing 21' 5" Steel
 (material) (depth)
 (size) if telescope see back.
 - (5) screen 70 90
 (length) (depth to top)
 (size) (material)
 - (6) pump 3/4 10
 (HP) (yield gpm)
Elect
 (type power)
 - (7) electric log (yes or no) _____
 (organization running log) _____
 - (8) how well bottom plugged _____


Note
315' 2" in Bottom
100' Slotted in Sand Pocket

DRILLERS REMARKS: _____

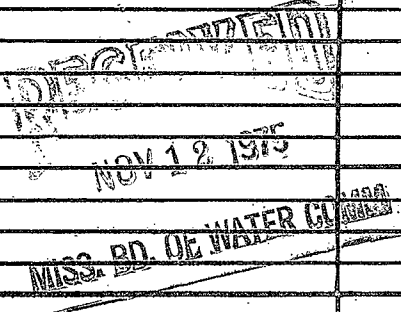

If well telescopes please sketch and show depths.

GROUND LEVEL

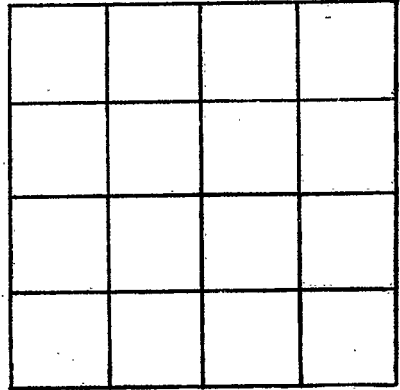

SECTION _____

Please indicate well location X.

ADDITIONAL INFORMATION

If more than one screen, show locations of each on sketch.