


Lowndes
 N 2001
 1975

MISSISSIPPI
 BOARD OF WATER COMMISSIONERS
 416 North State Street
 Jackson, Mississippi 39201

13L

WATER WELL DRILLERS LOG

1975 Guthon Drill Co. Lowndes
 date well completed Anthony firm name county well located

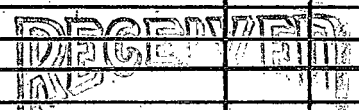LANDOWNER:	description of formations encountered	from	to
<u>Gardner Flying Serv.</u> <u>Crawford, Miss</u> (mailing address)	<u>Clay</u> <u>Limestone</u> <u>Sand & Shale</u>	<u>0</u> <u>5</u> <u>550</u>	<u>5</u> <u>550</u> <u>750</u>
WELL LOCATION:			
sec <u>3</u> T <u>17</u> N R <u>16</u> E <u>1</u> miles <u>South</u> of <u>Crawford</u> (distance) (direction) (nearest town)			
WELL PURPOSE: <u>Home</u>			
(home, irrigation, municipal, industrial)			
WELL COMPLETION DATA:			
(1) diameter (inches) <u>4"</u>			
(2) total depth (feet) <u>750</u>			
(3) static water level (feet) <u>90</u> ^{below} / _{above} top of ground.			
(4) casing <u>PVC</u> <u>20'</u> <u>730</u> (material) (depth)			
(size) if telescope see back.			
(5) screen <u>100'</u> <u>730</u> (length) (depth to top)			
<u>2"</u> <u>P.V.C.</u> (size) (material)			
(6) pump <u>1</u> <u>10</u> (HP) (yield gpm)			
<u>elect</u> (type power)			
(7) electric log <u>no</u> (yes or no)			
(organization running log)			
(8) how well bottom plugged <u>Backwash</u> <u>valve</u>			
DRILLERS REMARKS:			
<div style="text-align: right;">  FEB 26 1976 </div>			

If well telescopes please sketch and show depths.

GROUND LEVEL

20' 4"

PVC casing


Open Hole

Rubber Packers

100' 2"

PVC Screen

If more than one screen,
show locations of each on sketch.

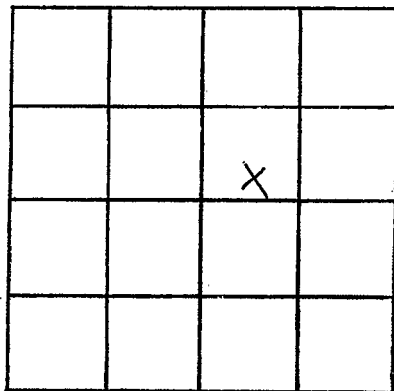

SECTION 32

Please indicate well location X.

ADDITIONAL INFORMATION

Horizontal lines for additional information.