

Lowndes
N 2002
1-30-76

MISSISSIPPI
 BOARD OF WATER COMMISSIONERS
 416 North State Street
 Jackson, Mississippi 39201

WATER WELL DRILLERS LOG

Jan 30 1976 date well completed ALLsup Drilling, INC. firm name Lowndes county well located

LANDOWNER: Mr. S.F. Potts
Boy 161
Crawford Ms. 39343
 (mailing address)

WELL LOCATION:
 sec 26 T 17 N R 16 E
2 miles East of Crawford
 (distance) (direction) (nearest town)

WELL PURPOSE: home
 (home, irrigation, municipal, industrial)

- WELL COMPLETION DATA:
- (1) diameter (inches) 4" x 2"
 - (2) total depth (feet) 620
 - (3) static water level (feet) 40 ^{below} ~~above~~ top of ground.
 - (4) casing ^{4"} plastic, 40',
 (material) (depth)
4" x 2" if telescope see back.
 (size)
 - (5) screen 20', 540
 (length) (depth to top)
2", plastic
 (size) (material)
 - (6) pump 1, 12
 (HP) (yield gpm)
Electric
 (type power)
 - (7) electric log NO
 (yes or no)
 - (8) how well bottom plugged CAP

description of formations encountered	from	to
<u>TOPSOIL</u>	<u>0</u>	<u>9</u>
<u>CLAY</u>	<u>9</u>	<u>20</u>
<u>BLUE ROCK</u>	<u>20</u>	<u>28</u>
<u>White Rock</u>	<u>28</u>	<u>516</u>
<u>SAND</u>	<u>516</u>	<u>522</u>
<u>MUCK</u>	<u>522</u>	<u>536</u>
<u>SAND</u>	<u>536</u>	<u>620</u>

RECEIVED

FEB 1 1977

DRILLERS REMARKS:

MISS. BD. OF WATER COMMISSIONERS

If well telescopes please sketch and show depths.


GROUND LEVEL

40' -
4" plastic casing

Rock

170'
2" Plastic

80'
Plastic
Screen

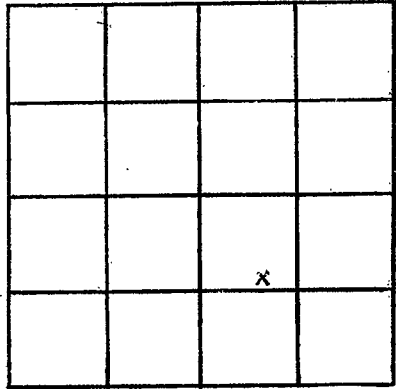

SECTION 26

Please indicate well location X.

ADDITIONAL INFORMATION

If more than one screen, show locations of each on sketch.