

Lowndes
N 2005
4/15/76

MISSISSIPPI
 BOARD OF WATER COMMISSIONERS
 416 North State Street
 Jackson, Mississippi 39201

[Handwritten signatures and notes]

WATER WELL DRILLERS LOG

~~4/15~~ 4/15 1976 Norman Chalk firm name Lowndes county well located


LANDOWNER: Mary Selvie
RFD #0 1
Crawford, Miss
 (mailing address)

description of formations encountered	from	to
	0	15
<u>Top Soil</u>	<u>0</u>	<u>15</u>
<u>Clay</u>	<u>15</u>	<u>120</u>
<u>Sand & Clay</u>	<u>120</u>	<u>800</u>

WELL LOCATION:
 sec 30 T 17 (N) R 16 (E)
 S 9 W
2 miles West of Wrayford
 (distance) (direction) (nearest town)

WELL PURPOSE: None
 (home, irrigation, municipal, industrial)

- WELL COMPLETION DATA:
- (1) diameter (inches) 4 1/2
 - (2) total depth (feet) 800
 - (3) static water level (feet) 130 below above top of ground.
 - (4) casing 126', 674'
 (material) (depth)
 if telescope spe back.
 - (5) screen Slotted pipe?
 (length) (depth to top)
 (size) (material)
 - (6) pump 3/4 100 GPM
 (HP) (yield gpm)
 (type power)
 - (7) electric log (yes or no)
 (organization running log)
 - (8) how well bottom plugged. Open

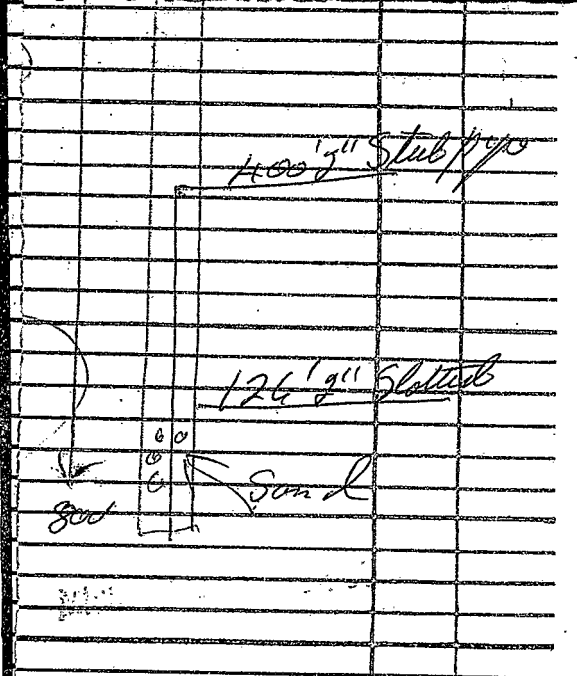

RECEIVED
 SEP 27 1976

MISS. DEPT. OF AGRICULTURE & FORESTRY


DRILLERS REMARKS:

MISS. STATE UNIV. MISSISSIPPI

SEP 27 1978

If well telescopes please sketch and show depths.

GROUND LEVEL

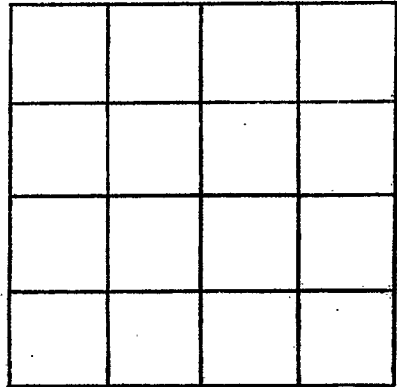

SECTION _____

Please indicate well location X.

ADDITIONAL INFORMATION

If more than one screen, show locations of each on sketch.