

LOWNDES
N 2006
5/15/76

MISSISSIPPI
 BOARD OF WATER COMMISSIONERS
 416 North State Street
 Jackson, Mississippi 39201

13L

WATER WELL DRILLERS LOG

5-15 1976 Anthony Drilling Co. Lowndes
 date well completed firm name county well located

LANDOWNER:
 Brady Thompson
 Crawford, Miss.
 (mailing address)


description of formations encountered	from	to
clay	0	4'
Limestone	4'	580'
Sand & Shale	580	830

WELL LOCATION:
 sec 22 T 17 N R 16 E
 2 miles NE of Crawford
 (distance) (direction) (nearest town)

WELL PURPOSE: Home
 (home, irrigation, municipal, industrial)

- WELL COMPLETION DATA:
- (1) diameter (inches) 4
 - (2) total depth (feet) 830
 - (3) static water level (feet) 80 below above top of ground.
 - (4) casing PVC, 20' top, (material) (depth)
 - (size) If telescope see back.
 - (5) screen 105' (length) (depth to top)
 - 2' PVC (size) (material)
 - (6) pump 3/4 (HP) 12 (yield gpm)
 - elect (type power)
 - (7) electric log no (yes or no)
 - (organization running log)
 - (8) how well bottom plugged Backwash is done

DRILLERS REMARKS:

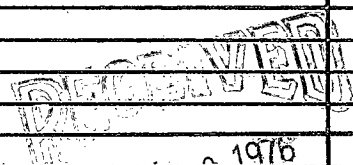

MISS. Bd. OF WATER COMMISSIONERS

If well telescopes please sketch and show depths.

GROUND LEVEL

20'
4" P.V.C.

Open Limestone

260'
2" P.V.C.
Casing

+
Screen

	X		

SECTION 22

Please indicate well location X.

ADDITIONAL INFORMATION

If more than one screen,
show locations of each on sketch.