

LOWNDES
N 2007
12-6-76

MISSISSIPPI
 BOARD OF WATER COMMISSIONERS
 416 North State Street
 Jackson, Mississippi 39201

136

WATER WELL DRILLERS LOG

12 6 1976 date well completed
 136 firm name: Alhsp Drilling Inc. Lowndes
 county well located

LANDOWNER: Mr. Johnson +
Lillie Bridges Jr.
Route 3 Box 8
Crawford, MS. 39743
 (mailing-address)

description of fomations encountered	from	to
<u>TOP SOIL</u>	<u>0</u>	<u>3</u>
<u>CLAY</u>	<u>3</u>	<u>32</u>
<u>Soft BLUE Rock</u>	<u>32</u>	<u>350</u>
<u>White Rock</u>	<u>350</u>	<u>775</u>
<u>MUCK</u>	<u>775</u>	<u>779</u>
<u>SAND</u>	<u>779</u>	<u>831</u>
<u>MUCK</u>	<u>831</u>	<u>835</u>
<u>WATER SAND</u>	<u>835</u>	<u>925</u>

WELL LOCATION:
 sec. 31 T. 17 N. R. 16 E.
1 3/4 miles W of CRAWFORD
 (distance) (direction) (nearest town)



WELL PURPOSE: FARM
 (home, irrigation, municipal, industrial)

- WELL COMPLETION DATA:
- (1) diameter (inches) 4" X 2"
 - (2) total depth (feet) 925'
 - (3) static water level (feet) 120' below top of ground.
 - (4) casing 4" PLASTIC 27'
 (material) (depth)
 - 4" X 2"
 (size) if telescope see back.
 - (5) screen PLASTIC 845'
 (length) (depth to top)
 - 2" PLASTIC
 (size) (material)
 - (6) pump 1 1/2 12
 (HP) (yield gpm).
 - Electric
 (type power)
 - (7) electric log NO
 (yes or no)
 - (organization running log)
 - (8) how well bottom plugged CAP

WATER
WELL
LOG
FEB 22 1977
 MISS. BD. OF WATER COMMISSIONERS

DRILLERS REMARKS:

If well telescopes please sketch and show depths.

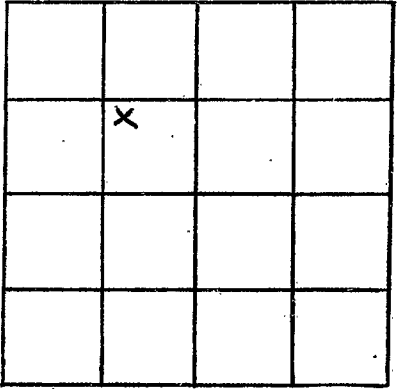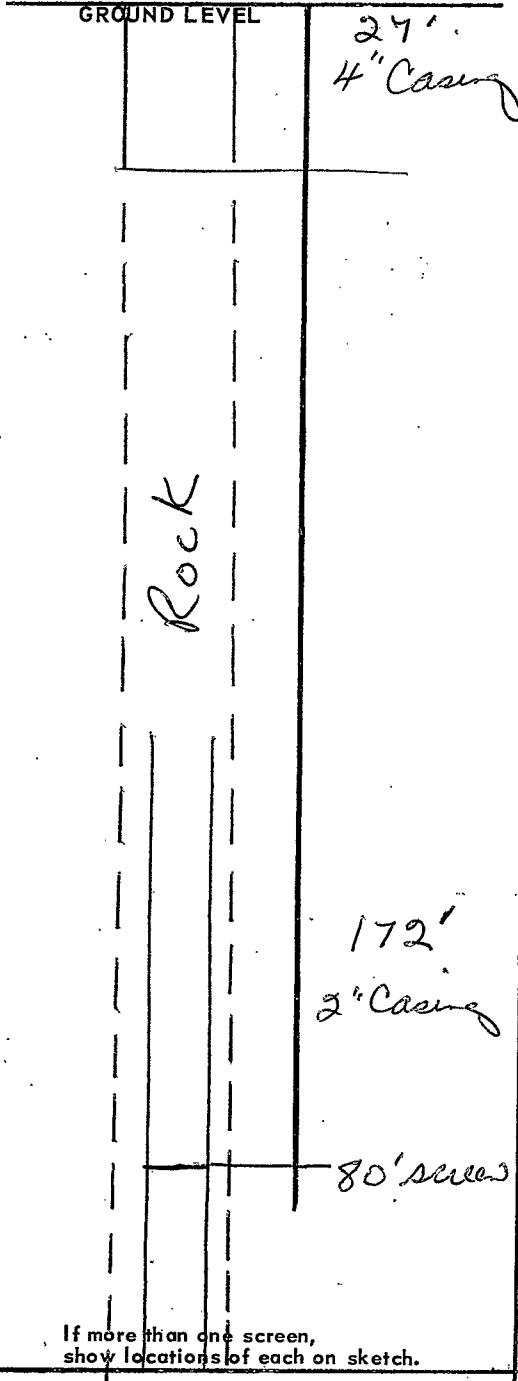

SECTION 31

Please indicate well location X.

ADDITIONAL INFORMATION

Lined area for additional information.

If more than one screen, show locations of each on sketch.