

Lowndes
N 208
12-20-76

MISSISSIPPI
 BOARD OF WATER COMMISSIONERS
 416 North State Street
 Jackson, Mississippi 39201

WATER WELL DRILLERS LOG

12-20-1976 date well completed ALL SUP DRILLING INC. firm name Lowndes county well located

LANDOWNER: Mr. Johnson &
Little Bridges Sr.
P.O. Box 144
Crawford, MS. 39443
 (mailing address)

description of formations encountered	from	to
TOP SOIL	0	3
CLAY MIXTURE	3	29
BLUE Rock	29	310
White Rock	310	764
MUCK	764	768
SAND	768	793
MUCK	793	805
SAND	805	925

WELL LOCATION:
 sec. 31 T. 17 N R. 16 E
1 3/4 miles W of Crawford
 (distance) (direction) (nearest town)

WELL PURPOSE:
 (home, irrigation, municipal, industrial)

- WELL COMPLETION DATA:
- (1) diameter (inches) 4" x 2"
 - (2) total depth (feet) 925'
 - (3) static water level (feet) 120 below top of ground.
 - (4) casing 2 1/2" plastic, 27'
 (material) (depth)
4" x 2" If telescope see back.
 (size)
 - (5) screen 80', 640'
 (length) (depth to top)
2", plastic
 (size) (material)
 - (6) pump 1 1/2, 12
 (HP) (yield gpm)
Electric
 (type power)
 - (7) electric log NO
 (yes or no)
 (organization running log)
 - (8) how well bottom plugged CAP

DRILLERS REMARKS:

FEB 22 1977


MISSISSIPPI WATER COMMISSIONERS

If well telescopes please sketch and show depths.

*Mr. Robert I. Jones Sr.
Johnson & Son -
place name of well*

GROUND LEVEL

27'
4" casing

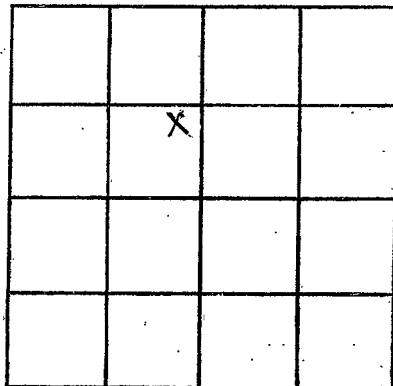

SECTION 31

Please indicate well location X.

ADDITIONAL INFORMATION

Rock

172'
2" casing

80' screen

If more than one screen, show locations of each on sketch.