

LOWNDES

N 2009

6-8-77

MISSISSIPPI BOARD OF WATER COMMISSIONERS
416 North State Street
Jackson, Mississippi 39201

WATER WELL DRILLERS LOG

June 8 1977 ALLSUD Drilling Co. LOWNDES
date well completed firm name county well located

LANDOWNER: Mr. JOHNNY
HILL Rt. 3 Box 24
Crawford MS. 39743
(mailing address)

description of formations encountered	from	to
Top Soil	0	2
Lime Rock	2	650
1st SAND	650	710
Muck	710	740
2nd SAND	740	900

WELL LOCATION:
sec 29 T 17 N R 16 E
2 miles W of Crawford
(distance) (direction) (nearest town)

WELL PURPOSE: Home
(home, irrigation, municipal, industrial)

WELL COMPLETION DATA:

- (1) diameter (inches) 4" x 2"
- (2) total depth (feet) 900'
- (3) static water level (feet) 170' below top of ground
- (4) casing 4" plastic, 30' (material) (depth)
4" x 2" if telescope see back. (size)
- (5) screen 80' 820' (length) (depth to top)
2" plastic (size) (material)
- (6) pump 1 1/2 HP 14 (yield gpm)
Electric (type power)
- (7) electric log NO (yes or no)

(organization running log)

(8) how well bottom plugged CAP


DRILLERS REMARKS:

RECEIVED
JUN 15 1978

MISS. BD. OF WATER COMM

If well telescopes please sketch and show depths.


GROUND LEVEL

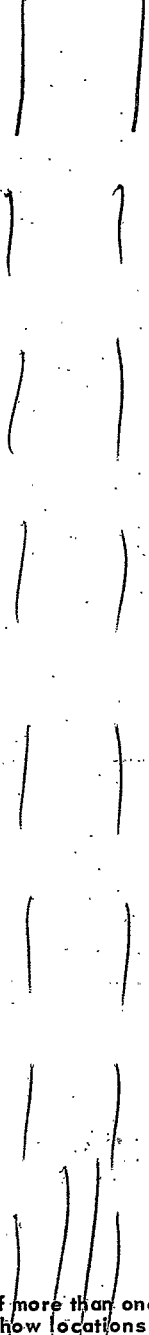

30'
4"
casing

240'
2"
casing
80'
c.
Screen

If more than one screen, show locations of each on sketch.

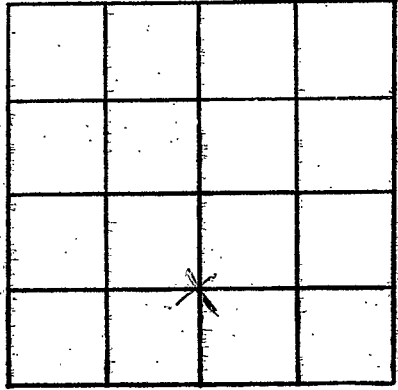

SECTION 29

Please indicate well location X.

ADDITIONAL INFORMATION

A series of horizontal lines provided for additional information, currently blank.