

LOWNDES  
 N 2010  
 7/5/77

MISSISSIPPI  
 BOARD OF WATER COMMISSIONERS  
 416 North State Street  
 Jackson, Mississippi 39201  
 WATER WELL DRILLERS LOG

13 E  
 000

7/5 date well completed 1977 HERMAN FOLLOWS firm name Lawrence county well located


LANDOWNER: <u>KATHLEEN BLAC</u>	Description of formations encountered	from	to
<u>R7D</u>			
<u>Crawford MISS</u> (mailing address)	<u>Top Soil</u>	<u>0</u>	<u>1</u>
	<u>Clay</u>	<u>1</u>	<u>560</u>
	<u>Sand</u>	<u>560</u>	<u>720</u>
<b>WELL LOCATION:</b>			
sec. <u>7</u> T. <u>17</u> (N) R. <u>16</u> (E)			
<u>5</u> miles <u>South</u> of <u>Ortana</u>			
(distance) (direction) (nearest town)			
<b>WELL PURPOSE:</b> (home, irrigation, municipal, industrial)			
<b>WELL COMPLETION DATA:</b>			
(1) diameter (inches) <u>4 1/2</u>			
(2) total depth (feet) <u>720</u>			
(3) static water level (feet) <u>?</u> <u>below</u> above top of ground.			
(4) casing <u>21' 6" Plastic</u> (material) (depth)			
_____ if telescope see back. (size)			
(5) screen _____ (length) (depth to top)			
_____ (size) _____ (material)			
(6) pump <u>1/2</u> <u>10</u> (HP) (yield gpm)			
_____ (type power)			
(7) electric log _____ (yes or no)			
_____ (organization running log)			
(8) how well bottom plugged <u>0</u>			
<b>DRILLERS REMARKS:</b>			

RECEIVED  
 AUG - 1 1977

MISS. BD. OF WATER COMM

If well telescopes please sketch and show depths.

GROUND LEVEL

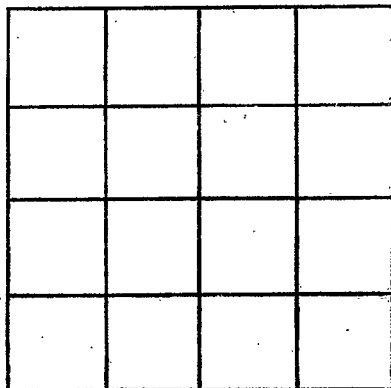

SECTION \_\_\_\_\_

Please indicate well location X.

ADDITIONAL INFORMATION

If more than one screen,  
show locations of each on sketch.