

LOWDES
N
2011

MISSISSIPPI  
 BOARD OF WATER COMMISSIONERS  
 416 North State Street  
 Jackson, Mississippi 39201

WATER WELL DRILLERS LOG

April 12 19 78 ALH sup Drilling Dr Lowndes  
 date well completed firm name county well located

LANDOWNER: St. James Baptist Church  
 George Taylor  
 Rt. 1 Box 283  
 Crawford MS 39743  
 (mailing address)

description of formations encountered	from	to
Top Soil	0	4
Line Rock	4	450
1st SAND	450	500
Muck	500	507
2nd SAND	507	607

WELL LOCATION:  
 sec 14 T 17 N R 16 E  
 3 1/2 miles NE of Crawford  
 (distance) (direction) (nearest town)

WELL PURPOSE: Church  
 (home, irrigation, municipal, industrial)

WELL COMPLETION DATA:  
 (1) diameter (inches) 4" x 2"  
 (2) total depth (feet) 607'  
 (3) static water level (feet) 100' below top of ground  
 (4) casing 4" x 2" Plastic, 26' (material) (depth)  
 4" x 2" if telescope see back.  
 (5) screen 80' x 527' (length) (depth to top)  
 4" x 2" Plastic (size) (material)  
 (6) pump 1/2 HP, 9 (yield gpm)  
 Electric (type power)  
 (7) electric log NO (yes or no)

(organization running log)  
 (8) how well bottom plugged CAP

DRILLERS REMARKS:


RECEIVED  
 MAY 24 1978

MISS. BD. OF WATER COMM

If well telescopes please sketch and show depths.

GROUND LEVEL

26'  
4" casing

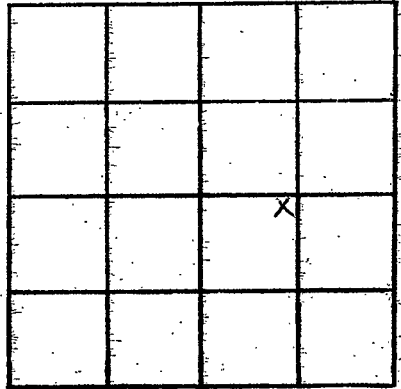

SECTION 14

Please indicate well location X.

ADDITIONAL INFORMATION

180'  
2" casing

80'  
2 Com.  
Screens

If more than one screen, show locations of each on sketch.